

CORNER INVESTIGATION REPORT

FS INDEX ID: E-8

CORNER: EAST 1/16 GCDB ID: 260600 DATE: 1/26/21
TOWNSHIP: 40S STATE: OREGON
RANGE: 3W COUNTY: JACKSON
SECTION: 5 & 8 FOREST: ROGUE RIVER-SISKIYOU NF
MERIDIAN: WILLAMETTE DISTRICT: SISKIYOU MOUNTAINS RD
NFSL PROPERTY BOUNDARY CORNER?: YES NO

HISTORY OF VISITATIONS:

LINE(S) POSTED:

MAINTAINED: NORTH-2020 EAST-2020

GUARD POST(S): NORTH EAST

CORNER HISTORY:

SET DURING FILED SURVEY 8683, BY KURT C. WEAVER

REGISTERED
PROFESSIONAL
LAND SURVEYOR

Jason M. Martin

OREGON
MAY 8, 2012
JASON M. MARTIN
54729

RENEWS: 1-1-2023

MONUMENT FOUND/SET:

2 1/2" BRASS CAP ON 2 1/2" PIPE, APPROX 0.5' EXPOSED, NO STONES


NOTE: THE TOWNSHIP MARKED ON THIS MONUMENT IS INCORRECT
THIS CORNER IS IN TOWNSHIP 40S

RECORD CORNER ACCESSORIES:

PER FILED SURVEY 8683
15" DIA FIR (NOW DEAD 12' TALL STUMP)
9" DIA FIR (NOW DEAD ON GROUND)

RECORD MEASUREMENTS:

BEARS S20°37'E, 12.8'

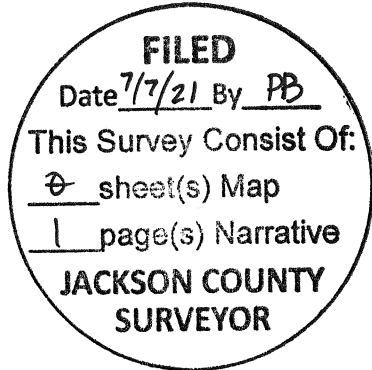

NEW CORNER ACCESSORIES:

16" DIA FIR BEARS N88°W, 30.5' TO 60D NAIL ON N'LY SIDE OF TREE
SCRIBED "E 1/16" "S5" "BT"
20" DIA PINE BEARS S39°E, 31.8' TO 60D NAIL ON E'LY SIDE OF TREE
SCRIBED "E 1/16" "S8" "BT"

METHOD OF MEASUREMENT:

COMPASS AND TAPE

CORNER MAINTENANCE/OTHER INFO:

CLEAR BRUSH FROM AROUND MONUMENT & TO BT'S. BT FACES & A 6" BAND AT HEAD HEIGHT PAINTED RED. ADD NEW NAILS TO BT TAGS & ADD NEW TAGS WHERE NEEDED. MONUMENT SIZES ARE OUTSIDE DIAMETER & BT DIAMETERS ARE AT BREAST HEIGHT.

CAP DIAGRAM:



GEODETTIC COORDINATES:

LATITUDE: N 42°06'45.8"
LONGITUDE: W 123°04'38.8"
ELLIPSOID HEIGHT: ~1876'
DATUM: WGS-84

DOCUMENTS ON FILE AT:

SOURCE: CONSUMER GRADE G.P.S.
DATE OF INVESTIGATION: 1/13/21
REPORT BY: JASON MARTIN

FIELD CREW: DENNIS H. MORTON, PARTY CHIEF
TOM MILSTEAD, FIELD TECH

THIS DOCUMENT FILED IN CS OFFICE:
OTHER DOCUMENT FILED WITH CS: