

CORNER INVESTIGATION REPORT

FS INDEX ID: G-5

CORNER: 1/4 **GCDB ID:** 200540 **DATE:** 1/14/21
TOWNSHIP: 40S **STATE:** OREGON
RANGE: 3W **COUNTY:** JACKSON
SECTION: 7&8 **FOREST:** ROGUE RIVER-SISKIYOU NF
MERIDIAN: WILLAMETTE **DISTRICT:** SISKIYOU MOUNTAINS RD
NFSL PROPERTY BOUNDARY CORNER?: YES NO

HISTORY OF VISITATIONS:LINE(S) POSTED:MAINTAINED:GUARD POST(S):CORNER HISTORY:

RE-MONUMENTED BY COUNTY SURVEYOR, M.E. BOYDEN, 1962
 VISITED DURING FILED SURVEY 8439, BY MALCOM M. CLARK
 VISITED DURING FILED SURVEY 8681, BY KURT C. WEAVER

**REGISTERED
 PROFESSIONAL
 LAND SURVEYOR**

Jason M. Martin

**OREGON
 MAY 8, 2012
 JASON M. MARTIN
 54729**

RENEWS: 1-1-2023MONUMENT FOUND/SET:

2 1/2" BRASS CAP ON 1 1/2" OUTSIDE DIA. PIPE, APPROX. 0.5' EXPOSED, NEXT TO ONE STONE INSIDE A SMALL RING OF STONES, GOOD CONDITION

RECORD MEASUREMENTS:

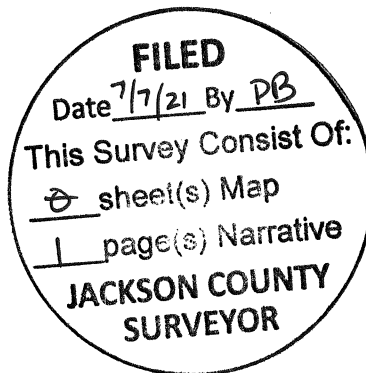
BEARS N43°E, 17.6'
 BEARS S20°E, 24.6'
 BEARS S22°W, 19.8'
 BEARS N67°W, 15.8'

RECORD CORNER ACCESSORIES:

PER FILED SURVEY 8439
 6" DIA. FIR NO EVIDENCE
 16" DIA. OAK (NOW 16.5") HEALED BLAZES
 24" DIA. PINE (NOW 26") HEALED BLAZES
 14" DIA OAK (NOW 14") LOWER BLAZE ROTTED
 24" DIA OAK (NOW 24") HEALED LOWER BLAZE, ROTTING UPPER BLAZE

METHOD OF MEASUREMENT:NEW CORNER ACCESSORIES:

NO NEW ACCESSORIES ESTABLISHED

CORNER MAINTENANCE/OTHER INFO:

CLEAR BRUSH FROM AROUND MONUMENT & TO BT'S. BT FACES & A 6" BAND AT HEAD HEIGHT PAINTED RED. ADD NEW NAILS TO BT TAGS & ADD NEW TAGS WHERE NEEDED. MONUMENT SIZES ARE OUTSIDE DIAMETER & BT DIAMETERS ARE AT BREAST HEIGHT.

CAP DIAGRAM:GEODETIC COORDINATES:

LATITUDE: N 42°06'19.3"
LONGITUDE: W 123°05'34.7"
ELLIPSOID HEIGHT: ~1861
DATUM: WGS-84

DOCUMENTS ON FILE AT:**SOURCE:** CONSUMER GRADE G.P.S.**DATE OF INVESTIGATION:** 12/14/20**REPORT BY:** JASON MARTIN

FIELD CREW: DENNIS H. MORTON, PARTY CHIEF
 TOM MILSTEAD, FIELD TECH
 RYAN BEIL, FIELD TECH

THIS DOCUMENT FILED IN CS OFFICE:OTHER DOCUMENT FILED WITH CS: