


PLAT

Surveyed Sept 19, 1963
of the
A.E. LA VALLEY
Property

Located in Section 10
T. 36 S., R. 4 W., W.M.
Jackson County, Oregon

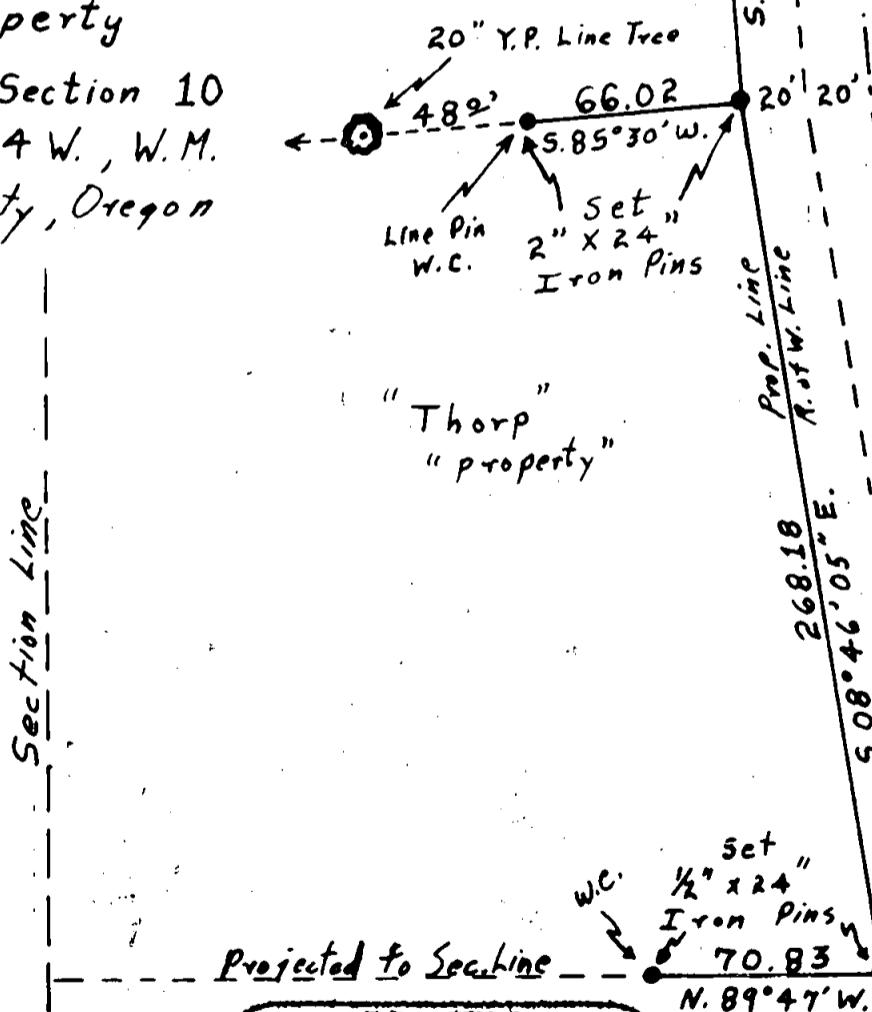


Scale: 1" = 66'

REGISTERED
OREGON
LAND SURVEYOR

NOVEMBER 18, 1963
S. SIDNEY SMYTHE
525

N
2342

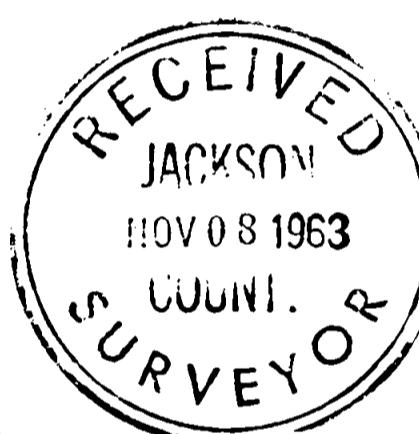

2342

S. Sidney Smythe

Page One

2342

Survey Narrative
A.E. LAVALLEY SURVEY

This survey was executed at the request of A.E. La Valley of Rt. 1, Box 17F; Rogue River, Oregon : for the purpose of obtaining a deed description of the south portion of his property for deed transfer.

I found the position of the $\frac{1}{4}$ corner between sec's. 9/10, T. 36 S., R. 4 W. to lie within the creek bed proper of Evans Creek. The N.E. B.T. was readily found, having been chopped out within the past year. The S.E. B.T. was found at recorded distance and bearing now being an 11" Oak Stump. I chopped out the cast of this bearing tree and gave same to Mr. La Valley for his convenience. I scribed one new B.T. as shown on plat, and monumented the $\frac{1}{4}$ corner as indicated.

I thence took the old deed description and placed the the old calls and bearings to latitudes and departures. Thence running south cardinallly to the given latitude, I thence set a I.P. on this line with the intersection of the west R.of.Way line of the East Evans Creek Road, thus placing the P.of Beginning for this property.

The property line between La Valley and Thorp was so placed as not to cut-off the well and pump house from the La Valley prop.

All pins and line run are self explanatory on the accompanying plat.

