


2349

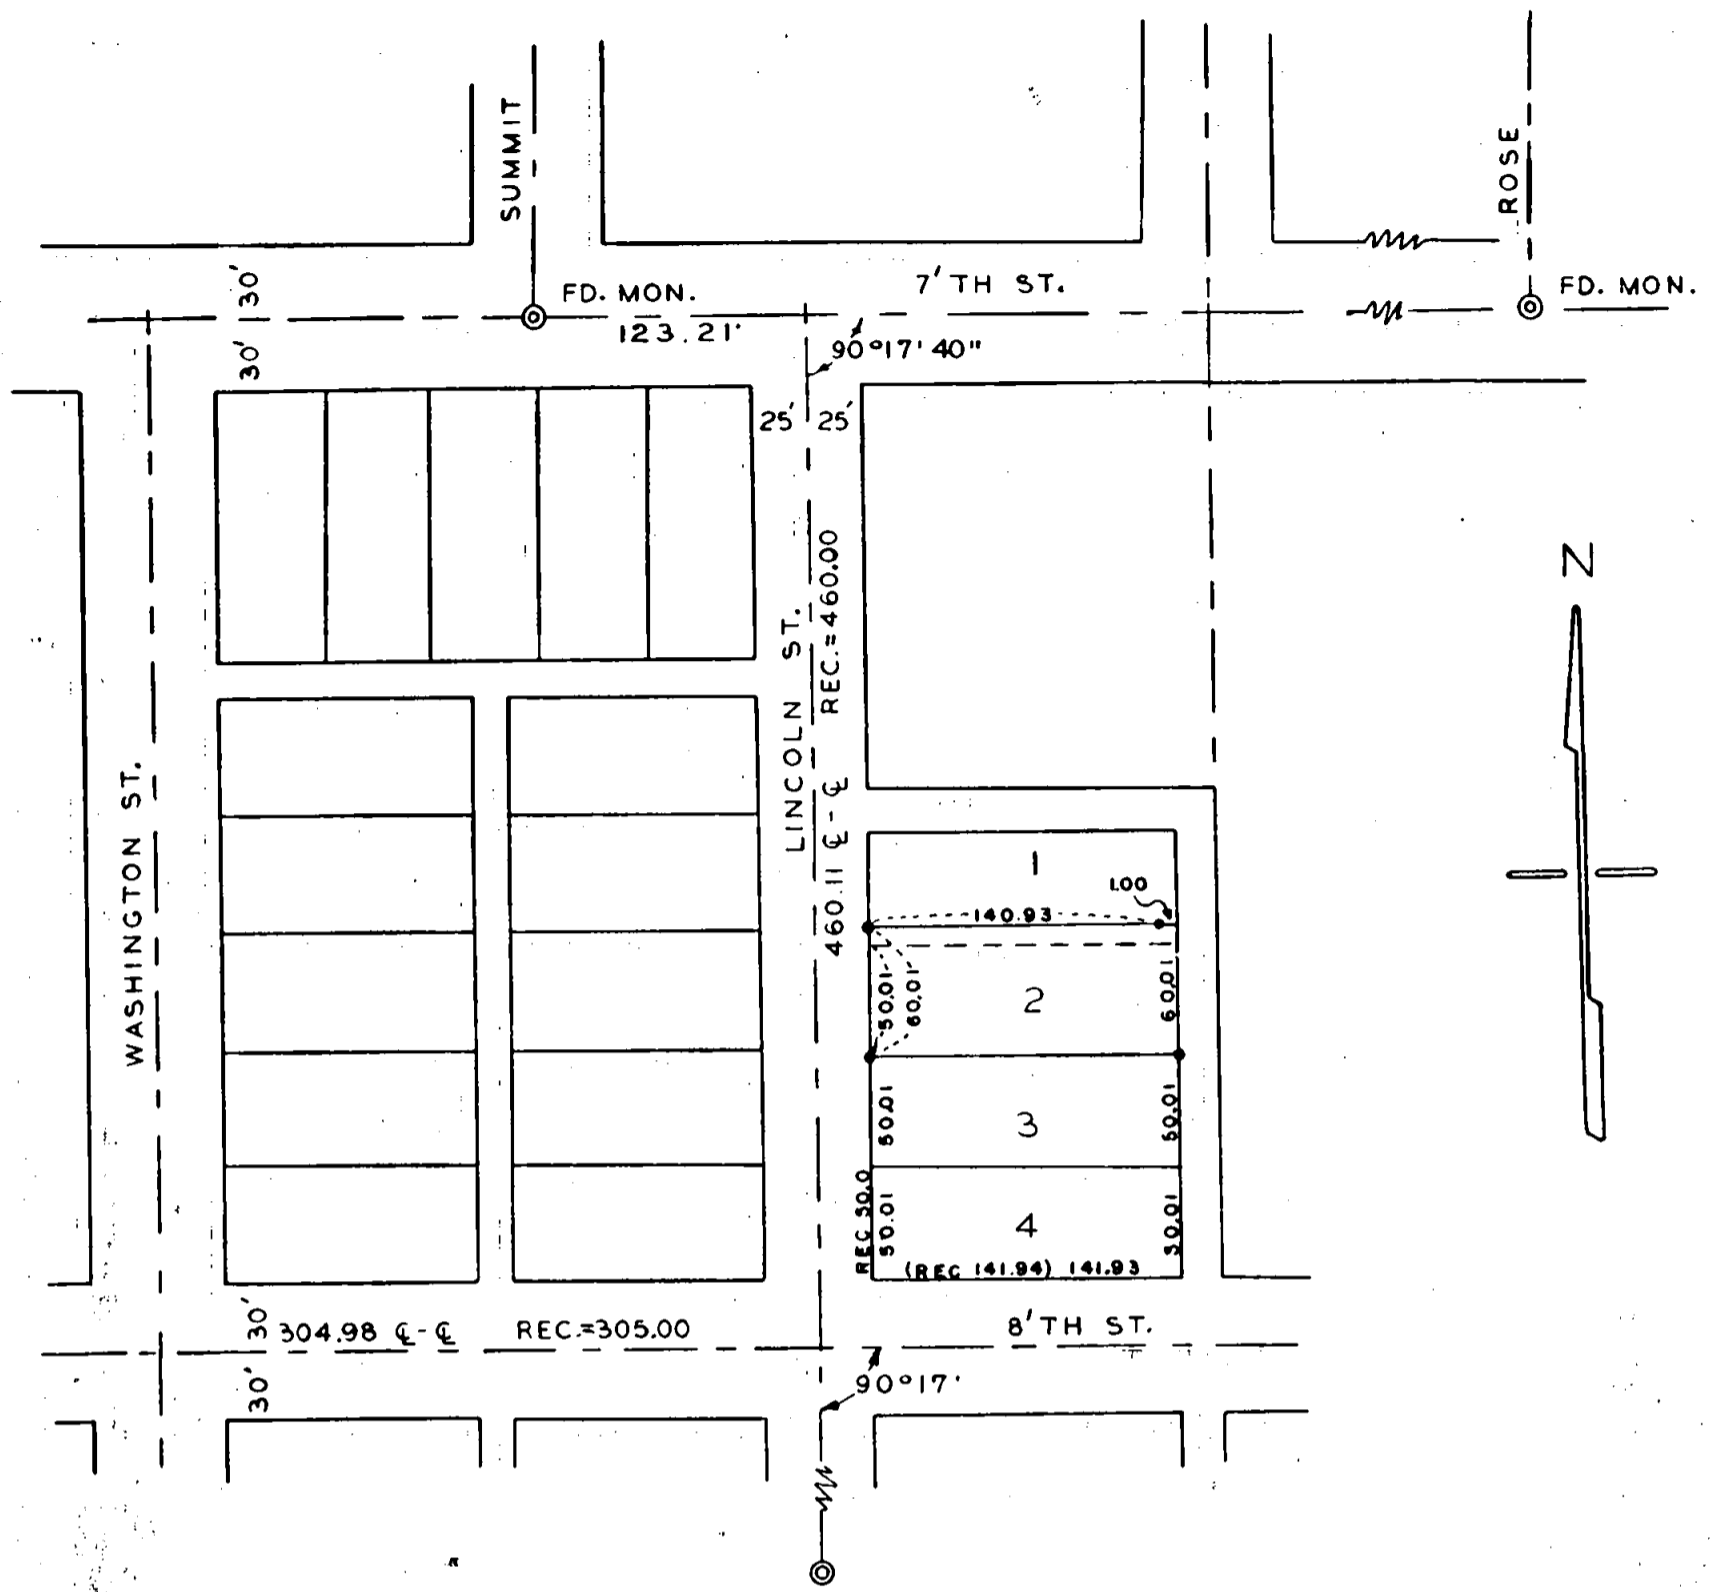

RECEIVED
 JACKSON
 NOV 18 1963
 COUNTY
 SURVEYOR

REGISTERED
 OREGON
 LAND SURVEYOR

Edward A. McGinty
 JULY 10, 1955
 EDWARD A. MCGINTY
 301

SURVEY IN LT. 1 & 2 BLK. 2 OAK GROVE SUB-D
 FOR
 JOHN NOVAK
 63 - 13

BY EDWARD MC GINTY
 MEDFORD OREGON
 MAY 1963

SCALE 1"=100'
 ● = 5/8" I. PIN

2349

Survey No. 2349

Survey Narrative to comply with O. R. S. 209-250.

Survey for: John Novak

Survey by: Edward A. McGinty, L.S.
7/8/63

BASIS OF BEARING: Previous survey.

PRECEDENCE OF SURVEY:

Using the same precedence as used in previous survey for Gilbert Johnson, being Lot 4, Blk. 2, surveyed Lots 2 and the southerly 10 feet of Lot 1, for Mr. Novak.

