


23501

# MAP OF SURVEY

LOCATED IN THE NORTHEAST 1/4 OF SECTION 17, TOWNSHIP  
37 SOUTH, RANGE 1 WEST, WILLAMETTE MERIDIAN, IN THE  
CITY OF MEDFORD, JACKSON COUNTY, OREGON

\*\* RECEIVED \*\*

DATE 11/29/21 BY JP  
This survey consists of:  
1 sheet(s) Map  
0 page(s) Narrative  
JACKSON COUNTY  
SURVEYOR

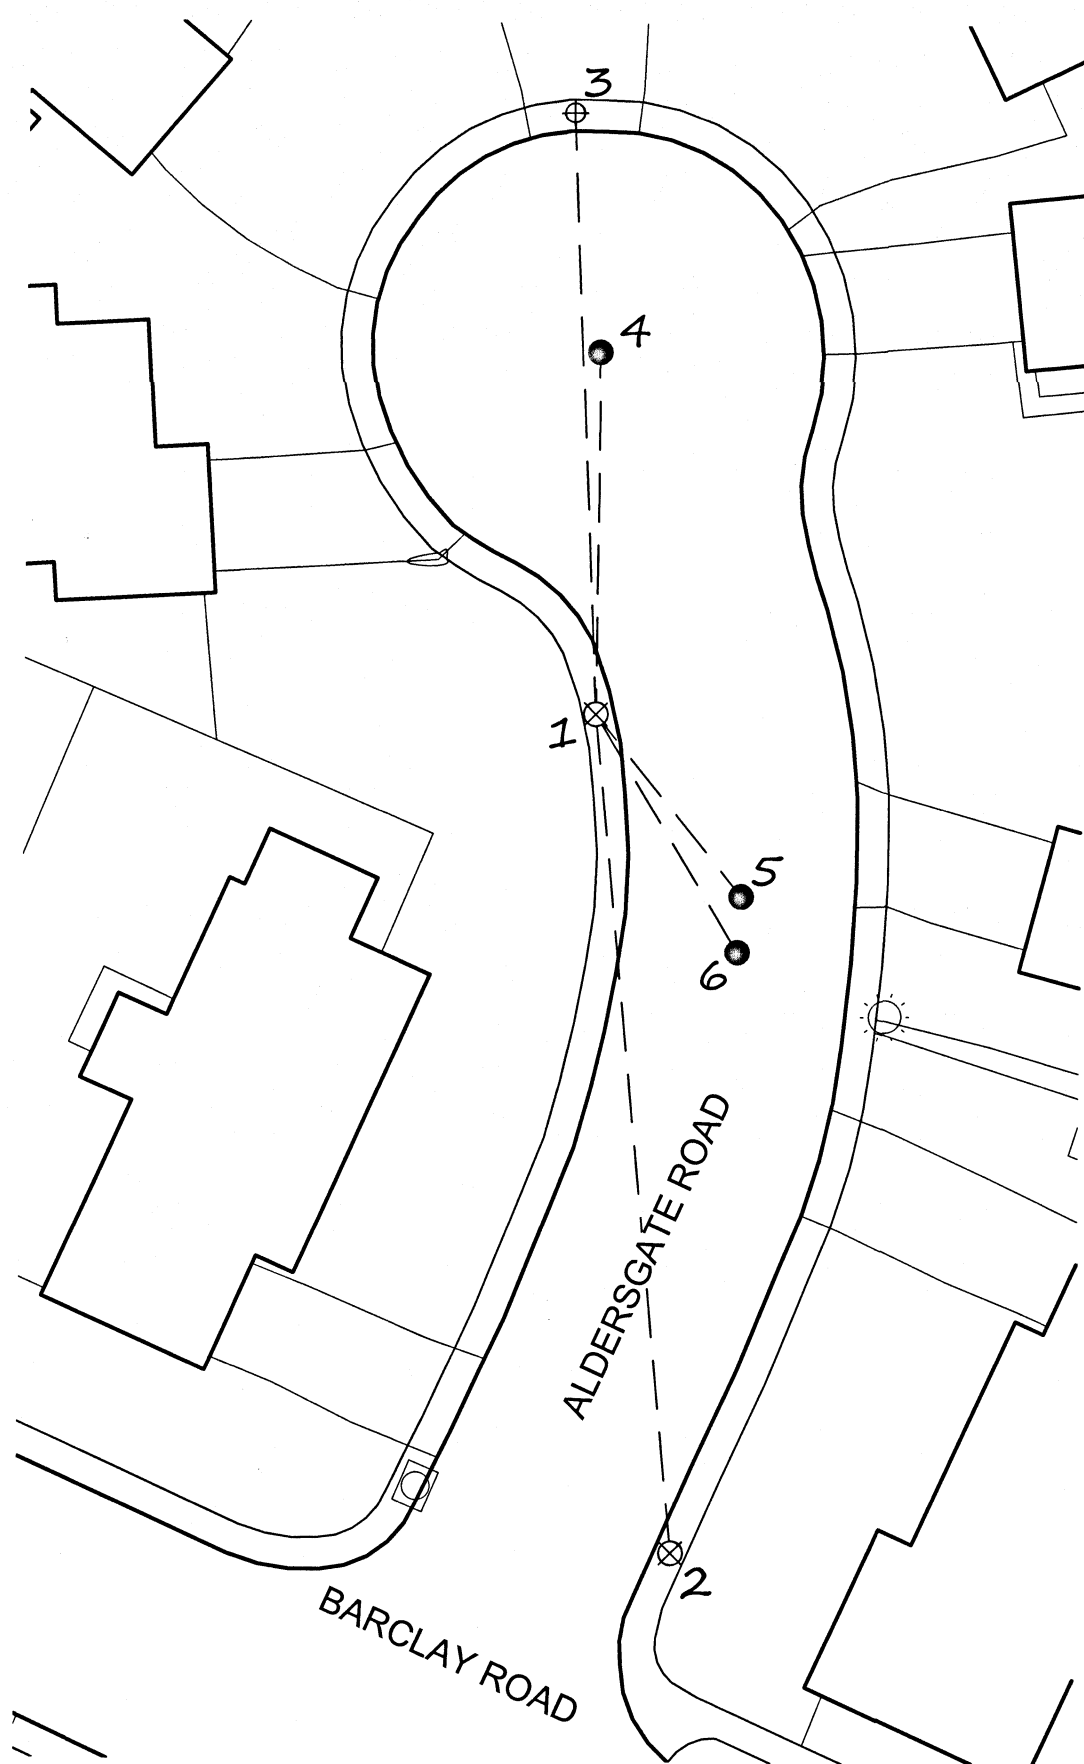

SET UP @ PNT 1  
BACK SIGHT AT PNT 2


PNT	ANGLE RIGHT	HORIZ DIST.
2	00-00-00	131.71
3	183-09-59	94.05
4	185-57-13	56.51
5	326-39-17	36.40
6	334-29-33	43.25

⊗ SET CUT "X" IN CONCRETE

● FOUND 2" BRASS CAP IN CONCRETE MARKED WITH PUNCH PER SURVEY NUMBER 8954 & 9027. MONUMENT DESTROYED BY CITY STREET OVERLAYS IN SUMMER OF 2021. A 5/8" REBAR WITH ALUMINUM CAP MARKED "CITY OF MEDFORD" IS RESET IN FOUND LOCATION AFTER CONSTRUCTION COMPLETE IN FALL OF 2021



ASSUMED NORTH - NO BEARINGS  
USED FOR THIS SURVEY

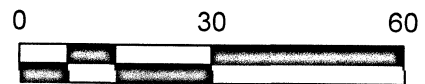

SCALE 1"=30'

REGISTERED  
PROFESSIONAL  
LAND SURVEYOR

*JP* 11/23/21  
OREGON  
JANUARY 9, 2007  
JON M. PROUD  
77652  
EXPIRES DECEMBER 31 2022

SURVEY NARRATIVE TO COMPLY WITH O.R.S. 209.250

SURVEY FOR/BY: CITY OF MEDFORD, 411 WEST 8TH STREET,  
MEDFORD, OREGON 97501

DATE OF SURVEY: MAY, 2021-NOVEMBER, 2021

PURPOSE: IN ACCORDANCE O.R.S. 209.150 THE PURPOSE  
OF THIS SURVEY IS TO PERPETUATE EXISTING MONUMENTATION  
FROM FILED SURVEY 8954 & 9027 CEDAR HILLS-UNIT NO 3

EQUIPMENT USED TO PERFORM THIS SURVEY CONSISTED OF  
UTILIZING A TRIMBLE S6 ROBOTIC TOTAL STATION AND TSC3 DATA  
COLLECTOR. MONUMENTS AT POINT NUMBERS 4, 5 AND 6 WERE TIED  
IN MAY OF 2021 IN PREPARATION FOR SUMMER OVERLAYS. SAID  
MONUMENTS WERE DESTROYED AND AFTER CONSTRUCTION WAS  
COMPLETE, A 5/8" REBAR WITH AN ALUMINUM CAP MARKED "CITY  
OF MEDFORD" WAS SET IN SAID FOUND LOCATION. MONUMENTS  
WERE SET BACK FROM CONTROL POINTS SET PRIOR TO  
CONSTRUCTION.

CITY OF MEDFORD - SURVEYING DEPARTMENT

ALDERSGATE ROAD 2021 OVERLAYS

DRAWN BY: ZPE	DATE 11/05/2021	PROJECT NO.
CHECKED BY: JP	DATE 11/05/2021	N/A
DATE REFERENCED: MAY, 2021		
DATE RESET: OCTOBER, 2021		SHEET NO.
CREW: Z. EARLE, S. METZGER		1 OF 1

371W17AA

23501

23501