



Survey No. 2351

Survey Narrative to comply with O. R. S. 209-250.

Survey for: Faydrex, Inc.  
843 E. Main

Survey by: Edward A. McGinty, L.S.  
7/8/63

BASIS OF BEARING: Solar observation.

PRECEDENCE OF SURVEY:

At the North 1/4 cor. of Sec. 21, found a 1 in. iron pipe in a rock mound and an old square post from which I found

White oak, now 28" dia., bears N.  $1\frac{1}{2}^{\circ}$ W., 29.7 ft. orig. BT.  
instead of N.  $10^{\circ}$ W., 29.70 ft.

White oak, now 16 in. diam., bears S.  $31^{\circ}$ W., 26.4 ft. orig. BT.  
instead of S.  $30^{\circ}$ W., 26.40 ft.

White oak 4 in. diam., bears S.  $30\frac{1}{2}^{\circ}$ W., 19.8 ft. CSBT.

White oak, 5 in. diam., bears S.  $78^{\circ}$ E., 31.2 ft. CSBT.  
Var.  $19\frac{1}{4}^{\circ}$

At Sec. cor. 21 and 22, found a stone 4x8x18 in. with 3 notches on the south face and 2 notches on the east face, from which

A stone, at the closing of Section 15 bears S.  $89^{\circ}22'50''$  East,  
59.99 ft. instead of S.  $89^{\circ}15'E.$ , 60.06 ft.

Face white oak, 12 in. diam., bears N.  $28\frac{1}{2}^{\circ}$ W., 67.3 ft., 2  
blazes no scribe.

Face white oak, 14 in. diam., bears S.  $15\frac{1}{4}^{\circ}$ E., 73.3 ft., 2  
blazes, no scribe

At closing corner between Sec. 15 & 16 found a stone 6x6x?, C C or north  
face from which

Section

Section line bears North 0.30 ft.

Snag, 6 in. diam., bears N.  $23\frac{1}{2}^{\circ}$ W., 32.3 ft. to the center of orig. BT.

Snag, 8 in. diam., bears N.  $80^{\circ}$ E., 28.9 ft. to the center of orig. BT.  
instead of 30.36 ft.


The North 1/4 cor. of Sec. 22, found a stone 14x8x7 in. with 1/4 mkd. on  
N. face, set 1/2 in. iron pin under stone, from which

Down snag, 20 in. diam., (black oak) bears N.  $45^{\circ}$ E., 46.2 ft. orig. BT.

Face white oak, 7 in. diam., bears N.  $2^{\circ}$ E., 19.6 ft., 2 blazes

Face black oak, 6 in. diam., bears S.  $68\frac{1}{4}^{\circ}$ E., 22.1 ft.

The interior lines shown in Sec. 21 and 22 are in no way intended or construed  
to be 1/16 lines, client is aware that the lines are only approx.

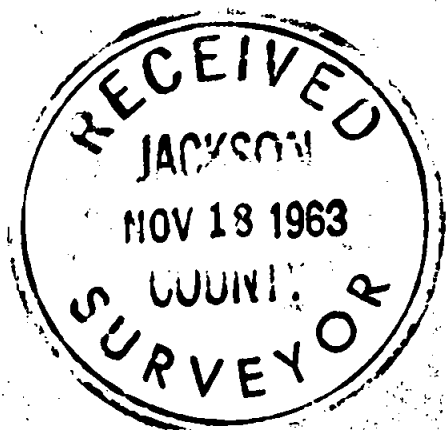

*Edward A. McGinty*  
JULY 10, 1963  
EDWARD A. MCGINTY  
301