37S2W30D TL 2300/2400

PROPERTY LINE ADJUSTMENT CITY OF JACKSONVILLE PLANNING (PLANNING FILE NO. 2022-011)

EXAMINED AND APPROVED THIS 15 DAY OF February JACKSONVILLE PLANNING DEPARTMENT

TAX LOT 2300 ADJUSTED PER DOC. NO. 2022-005353 O.R.J.C.O.

TAX LOT 2400 ADJUSTED PER DOC. NO. 2022-005354 O.R.J.C.O.

Property Line Adjustment

Located in:

in the SE 1/4 OF Section 30, T37S, R2W, WM. City of Jacksonville, Jackson County, Oregon Tax Lots 2300 & 2400

Adam & Amber Sobolik 310 Pair-A-Dice Ranch Road 300 Pair-A-Dice Ranch Road Jacksonville, Oregon 97530

Eric Morrell & Marty McGuire Jacksonville, Oregon 97530

SURVEY NARRATIVE TO COMPLY WITH PARAGRAPH 209.250 OREGON REVISED STATUTES

PURPOSE: TO SURVEY AND MONUMENT A PROPERTY LINE ADJUSTMENT OF PROPERTY DESCRIBED IN DOCS. NO. 2009-011188 AND 2021-022573. (CITY OF JACKSONVILLE PLANNING FILE NO. 2022-011). THE OBJECTIVE IS FOR TAX LOT 2400 TO OBTAIN ENOUGH PROPERTY FOR PROPOSED RESIDENTIAL EXPANSION AND FOR TAX LOT 2300 TO OBTAIN THE ZONING MINIMUM OF 2.00 ACRES.

PROCEDURE: I RECOVERED MONUMENTS SET PREVIOUSLY ON SURVEYS NO. 3454, 5199, 7207 AND 8444 AND ANALYZED THEIR POSITIONING IN RELATION TO DEED DESCRIPTION. AS MOST WERE WITHIN ACCEPTABLE LIMITS AND THE DESCR-IPTIONS CALLED TO THE MONUMENTS, I ACCEPTED THEIR LOCATIONS UNLESS BENT. THE LOCATION OF THE EASTERLY LINE FROM SURVEY NO. 8444 IS COINCIDENT WITH THE MONUMENTS SET FOIR THE CENTERLINE OF PAIR-A-DICE RANCH ROAD DEPICTED ON SURVEY NO. 3454. I ESTABLISHED THE EASTERLY LINE OF THE PROPERTY PARALLEL AND 30.00 FEET WESTERLY OF THE RECORD LOCATION OF SURVEY NO. 8444. THIS POSITION IS NOT REF-LECTIVE OF THE ACTUAL ROAD DEDICATION AS DESCRIBED IN DOC. NO. 70-11797 WHICH INCORPORATES CURVES.

EQUIPMENT USED: TRIMBLE S6 ROBOTIC INSTRUMENT & TRIMBLE R8 GNSS.

HOFFBUHR & ASSOCIATES, INC. 880 GOLF VIEW DR. STE. 201 MEDFORD, OREGON (541) 779-4641

BY: DAVID M. MINNECI SCALE: 1 INCH = 80' BASIS OF BEARING:

RPLS NO. 2349 FEBRUARY 1, 2022 SURVEY NUMBER 8444 (WEST LINE)


SET 5/8" x 24" IRON PIN WITH PLASTIC CAP STAMPED "D. MINNECI LS 2349". 0

FOUND 5/8" IRON PIN PER S/N 7207.

FOUND 5/8" PIN PER S/N 8444.

FOUND 5/8" IRON PIN PER S/N 3454, 5199 OR AS NOTED.

S/N SURVEY NUMBER

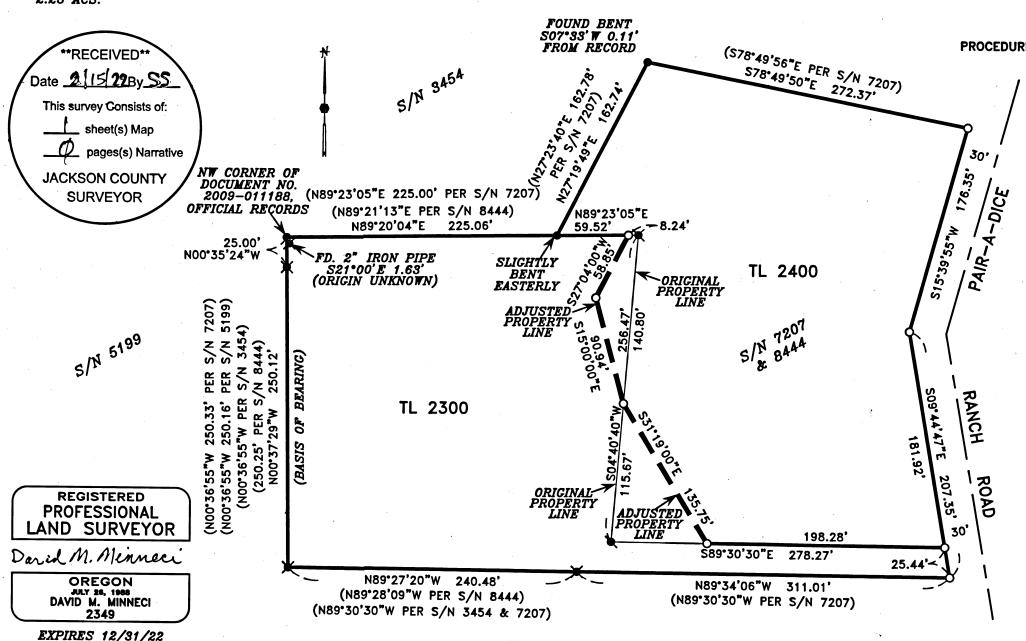

 $(C; DWG \setminus 2021 \setminus 21186MOS, DWG)$