PLASTIC CAP

O.D. OUTSIDE DIAMETER

RECORD INFORMATION


FIELD MEASUREMENT

ASSESSOR'S MAP NUMBER 332W, T.L. 3000 & 3100

BRASS CAP

BLACK OAK

INCENSE CEDAR

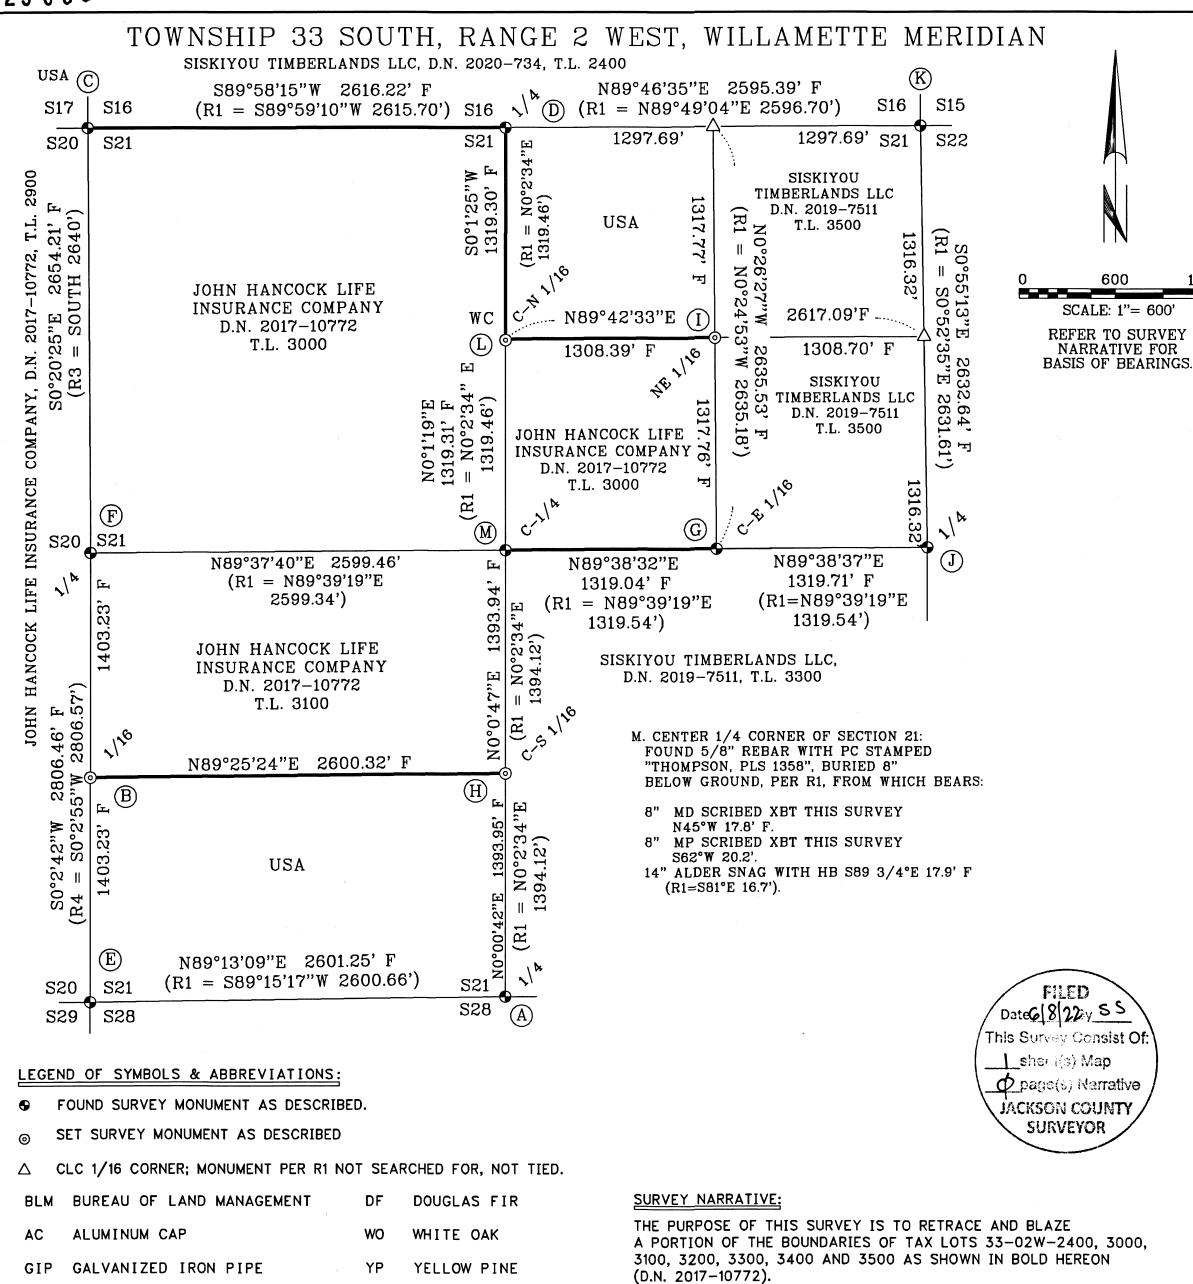

MADRONE

HEALED BLAZE

D.N. DOCUMENT NUMBER

GLO GENERAL LAND OFFICE

VISIBLE SCRIBING

MAPLE

T.L. TAX LOT

TREES WITHIN THREE FEET, ON BOTH SIDES OF THE BOLD LINES, WERE QUARTER-BLAZED AND PAINTED RED.

THIS SURVEY WAS CONDUCTED USING A TOPCON GPT 3005W TOTAL STATION AND TOPCON HIPER GA STATIC GPS UNITS. THE FIELD SURVEY COMMENCED JANUARY 19, 2022 AND WAS COMPLETED APRIL 15TH, 2022.

THE BASIS OF BEARINGS FOR THIS SURVEY IS ASTRONOMIC, AT THE 1/4 CORNER OF SECTIONS 21 AND 16 SHOWN HEREON, BASED ON A SOLAR OBSERVATION TAKEN AT SAID CORNER.

ALL FIELD BEARINGS AND DISTANCES TO BEARING TREES ARE TO THE CENTER OF THE TREE AT THE GROUND.

- A. 1/4 CORNER OF SECTIONS 21 & 28:
 FOUND 2 1/2" O.D. GIP WITH 3 1/4" BLM BC
 STAMPED "1/4 S21 S28 T33S R2W 1958",
 10" ABOVE GROUND, PER 1, FROM
 WHICH BEARS:
- 40" BO SNAG WITH HB 27 3/4°W 57.4' F (R1=N79 1/2°W 58.1').
 ROTTED DF STUMP N28 1/2°E 64.6' F=R1.
 27" DF STUMP WITH HB S58°E 36.5' F=R1.
- B. S 1/16 COR OF SECTIONS 20 AND 21: SET 1 1/2" GIP WITH 2 1/2" AC STAMPED "S 1/16 COR S20 S21 T33S R2W PLS 77662", 8" ABOVE GROUND, FROM WHICH BEARS:
- 20" MD SCRIBED XBT THIS SURVEY

1200

- N55°W 6.1' F. 6" DF SCRIBED XBT THIS SURVEY S87 1/2°W 7.6' F.
- C. CORNER OF SECTIONS 17, 16, 20, & 21: FOUND 2 1/2" O.D. GIP WITH BLM BC STAMPED "S17 S16 S20 S21 T33S R2W 1965", 6" ABOVE GROUND, PER R1, FROM WHICH BEARS:
- 29" DF WITH HB N34°W 28.8' F=R1. 19" DF WITH HB N73°E 44.8' F=R1. 33" DF WITH HB S84°W 53.3' F=R1. 20" DF WITH HB S69°E 37.4' F=R1.
- D. 1/4 CORNER OF SECTIONS 16 & 21
 FOUND 2 1/2" O.D. GIP WITH 3 1/4" BLM BC
 STAMPED "1/4 S16 S21 T33S R2W 1965",
 12" ABOVE GROUND, IN A 2' STONE COLLAR,
 PER R1, FROM WHICH BEARS:
- 6" IC WITH ALUMINUM TAG MARKED "PLS 7762" NAILED TO LOW BLAZE THIS SURVEY N9 1/4°E 17.2' F.
 27" DF HB S83°E 56.1' F=R1.
- E. CORNER OF SECTIONS 20, 21, 29 & 28, FOUND 2 1/2" O.D. GIP WITH 3 1/4" BLM BC STAMPED "T33S R2W S20 S21 S29 S28 1965", 30" ABOVE GROUND IN 4' MOS, PER R1.
- 17" BO SNAG WITH ROTTEN BLAZE N63°E 19.3' F=R1.
- 12" MD AXED "X" THIS SURVEY

FROM WHICH BEARS:

- N47 3/4°W 5.6' F. 27" DF WITH HB S34°W 46.8' F=R1.
- 31" DF SNAG WITH HB 14' TALL N58°W 35.1' F=R1
- 11" BO SNAG WITH ROTTEN BLAZE S85°W 28.7' F=R1.
- 11' BASALT BLUFF MARKED BXO S89°E 28.4' F=R1.
- F. 1/4 CORNER OF SECTION 20 & 21, FOUND 2 1/2" O.D. GIP WITH 3 1/4" BLM BC STAMPED "T33S R2W 1/4 S20 S21 1965", 10" ABOVE GROUND, FROM WHICH BEARS:
- 15" DF WITH HB S49°E 13.9' F=R2. 16" DF WITH HB S60°W 28.8' F=R2. 17" IC WITH VS N76 1/4°E 29.3' F=R2. 7" IC WITH VS N74°W 23.7' F=R2.
 - REGISTERED
 PROFESSIONAL
 LAND SURVEYOR

 OREGON
 JULY 11, 2006
 GREGG ARNOLD NEITSCH
 77662LS
 EXPIRES: 12/31/2022

REFERENCES:

R1 = C.S. 9433 (THOMPSON)

R2 = C.S. FIRST RE-ESTABLISHMENT (2008)

OF THE 1/4 CORNER OF S20 AND S21

R3 = 1885 GLO SURVEY BY MOORE

R4 = C.S. 22486 (FARBER)

- G. C-E 1/16 CORNER OF SECTION 21: FOUND 5/8" REBAR WITH PC STAMPED "THOMPSON PLS 1358", 2" ABOVE GROUND, PER R1, FROM WHICH BEARS:
- 12" DF SNAG WITH VS N39°W 25.8' F=R1.
 18" DF SNAG WITH HB N50° E 16.5' F=R1.
 12" WO SCRIBED XBT THIS SURVEY
 N 30 3/4°W 18.2' F.
 4" YP SCRIBED XBT THIS SURVEY
- S53 1/2°E 3.0' F. 1" IRON PIPE NO ID S46 1/4°W 122.49 F (R1=S46 1/4°W 122.97).
- H. CENTER-SOUTH 1/16 CORNER OF SECTION 21: SET 5/8" REBAR 30" LONG WITH 2 1/2" AC STAMPED "T33S R2W S 1/16 S21 PLS 77662 2022" 4" ABOVE GROUND, FROM WHICH BEARS:
- 9" DF SCRIBED XBT THIS SURVEY N43°W 6.6'. 18" DF SCRIBED XBT THIS SURVEY S63 1/4°W 18.0'.
- I. NORTHEAST 1/16 CORNER OF SECTION 21: SET 5/8" REBAR, 30" LONG WITH 2 1/2" AC STAMPED "T33S R2W NE 1/16 S21 PLS 77662 2022" 6" ABOVE GROUND, FROM WHICH BEARS:
- 8" YP SCRIBED XBT THIS SURVEY S89 1/2°E 35.4'. 12" DF SCRIBED XBT THIS SURVEY N20° E 8.0'.
- J. 1/4 CORNER OF SECTIONS 21 AND 22: FOUND 2 1/2" O.D. GIP WITH 3 1/4" BLM BC STAMPED "T33S R2W 1/4 S21 S22 1965", 12" ABOVE GROUND FROM WHICH BEARS
- 10" DF WITH HB N24°E 12.4' F=R1.
 10" DF SNAG WITH HB N24°E 12.4' F=R1.
 ROTTED BO STUMP HOLE S87 1/4° E 38.7' F
 (R1=S85°E 37.1).
- K. CORNER OF SECTIONS 16, 15, 21, & 22:
 FOUND 2 1/2" O.D GIP WITH 3 1/4" BLM BC
 STAMPED "S16 S15 S21 S22 T33S R2W 1965",
 14" ABOVE GROUND IN A 2' STONE COLLAR,
 PER R1, FROM WHICH BEARS:
- 24" ROTTED DF STUMP WITH HB N66°E 26.4' F=R1.
 ROTTED YP STMP WITH VS S25°E 35.6' F=R1.
 17" DF STUMP WITH HB S38 1/2°E 53.6' F
 (R1=S38°E 52.1').
 18" ROTTED DF STUMP S45°W 48.5' F=R1.
 24" ROTTED DF STUMP N8°W 37.0' F=R1.
- L. CENTER-NORTH 1/16 CORNER OF SECTION 21: POINT FALLS IN DIRT ROAD FROM WHICH BEARS:

SET 5/8" REBAR, 30" LONG, WITH 2 1/2" AC STAMPED "WC T33S R2W N 1/16 S21 6.8' PLS 77662 2022" WITH AN ARROW POINTING TOWARDS THE CORNER, 2" ABOVE GROUND, AS AN OFF-LINE WITNESS CORNER, S3°03'W 6.78' FROM TRUE CORNER. FROM THIS WITNESS CORNER BEARS:

8" YP SCRIBED XBT THIS SURVEY N35 1/3°E 38.3'. 8" MP SCRIBED XBT THIS SURVEY N70 1/4°W 21.1'.

MAP OF SURVEY

FOR

HANCOCK FOREST MANAGEMENT

LOCATED IN SECTION 21,
TOWNSHIP 33 SOUTH, RANGE 2 WEST, W.M.,
JACKSON COUNTY. OREGON

NORTH STATE LAND SURVEYING 1511 KYLYNN CT. MOUNT SHASTA, CA

APRIL 20, 2022 SCALE: 1"=600' SHEET 1 OF 1 HSCMAP.ASC LEAVECLEAVE.GXD JOB NO. 732 DB: DN