

1/4 CORNER OF SECTION 33 T.36S. R.3E. & SECTION 4, T.37S. R.3E.

FOUND BLM 2 1/2" O.D. GIP WITH 3 1/4" BC STAMPED "T36S R3E 1/4 S33 S4 T37S 1961," 12" ABOVE GROUND IN A 3' MOS, PER R6. FROM WHICH BEARS:

TOWNSHIP 36 SOUTH, RANGE 3 EAST, W.M.

CORNER OF SECTION 33 & 34, T.36S. R.3E. & SECTIONS 3 & 4, T.37S. R.3E.:

FOUND 3" O.D. GIP WITH 3" BC STAMPED "T36S R3E S33 S34 S3 T37S 2012 LS 2561", FLUSH WITH GROUND, PER R6. FROM WHICH BEARS:

33" IC WITH VS N43°12'E 65.00' F=R8
12" IC WITH HB N42°06'W 67.27' F=R8
REFERENCE MONUMENTS PER R5 NOT TIED THIS SURVEY.



0 300 600
SCALE: 1"= 300'
REFER TO SURVEY NARRATIVE FOR BASIS OF BEARINGS.

REFERENCES:

- R1 = CS 22240
- R2 = CS 8886
- R3 = CS 23567
- R4 = CS 1527
- R5 = CS FIRST REESTABLISHMENT OF THE NORTHEAST CORNER OF SEC. 4, T.37S., R.3E., W.M.
- R6 = CS FIRST REESTABLISHMENT OF THE 1/4 CORNER OF SEC. 33, T.36S., R.3E., & SEC. 4, T.37S., R.3E., W.M.
- R7 = GLO PLAT FOR T.37S., R.3E., W.M., APPROVED JULY 17, 1882.
- R8 = CS 21267

LEGEND OF SYMBOLS & ABBREVIATIONS:

- FOUND MONUMENT AS DESCRIBED.
- ⊙ SET 5/8" REBAR, 30" LONG, 24" IN THE GROUND, WITH 2 1/2" AC STAMPED PER BLM 2009 MANUAL OF INSTRUCTIONS AND "PLS 77662".
- AC ALUMINUM CAP
- BC BRASS CAP
- CLC CALCULATED
- D&D DEAD & DOWN
- DF DOUGLAS FIR
- D.N. DOCUMENT NUMBER
- F FIELD MEASUREMENT
- GIP GALVANIZED IRON PIPE
- GLO GENERAL LAND OFFICE
- HB HEALED BLAZE
- IC INCENSE CEDAR
- I.D. INSIDE DIAMETER
- MOS MOUND OF STONE
- O.D. OUTSIDE DIAMETER
- VS VISIBLE SCRIBING
- WF WHITE FIR
- () RECORD DATA

U.S.A. 373E T.L. 600

1/4 CORNER OF SECTIONS 3 & 4, T.37S. R.3E.:

FOUND 2" I.D. GIP WITH 2 1/2" BC STAMPED "T37S R3E 1/4 S4 S3 1981 LS 1071", 8" ABOVE GROUND IN A 3' MOS, PER R2. FROM WHICH BEARS:

32" DF WITH HB S89 3/4°W 50.1' F (S89°49'W 49.60' R2)
30" DF WITH HB N45 3/4°E 34.9' F (N46°12'E 35.06' R2)
25" DF WITH HB N 5 1/2°E 91.8' F (S5°44'W 91.59' R2)

REGISTERED PROFESSIONAL LAND SURVEYOR

GREGG ARNOLD NEITSCH
77662LS
EXPIRES: 12/31/2022

SEC. 33

7" IC WITH VS N2°E 11.7' F (N5°E R6)
28" IC WITH HB S39°W 28.3' F (S37°W 28.0' R6)

(N89°20'06"E 2654.20' R1)
(N89°56'10"E 2654.10' R2)
(EAST 2640' R7)

N89°53'29"E 2654.24' F (TIE ONLY)

SEC. 33 SEC. 34

SEC. 4

TOWNSHIP 37 SOUTH, RANGE 3 EAST, W.M.

SEC. 4 SEC. 3

LOT 3 SEC. 4

LOT 2 SEC. 4

LOT 1 SEC. 4

TODARO
D.N. 96-42078
373E04 T.L. 400

U.S.A. 373E04 T.L. 900

(1313.20' R1)
(1308.78' R4)
(1313.06' CLC)

CS 22240

COOK
D.N. 00-28967
373E04 T.L. 500 & 600

(1295.54' CLC)
(1295.21' R1)
(1295.58' R4)

373E04 T.L. 800

C-N 1/16

N 1/16

(S0°20'28"E 2651.56' F)
(S0°53'52"E 2651.83' R1)
(S0°18'00"E 2653.14' R2)
(S0°20'E 2649.90' R4)
(S0°25'30"W 2614.92' R7)

CENTER-NORTH 1/16 CORNER OF SECTION 4, T.37S. R.3E.:

S89°30'45"W 2649.28' CLC
(S89°41'W 2651.22' R4)
(S88°56'46"W 2649.49' R1)

NORTH 1/16 CORNER OF SECTIONS 3 & 4, T.37S. R.3E.:

SET 5/8" REBAR WITH 2 1/2" AC STAMPED "T37S R3E N 1/16 S4 S3 PLS 77662 2022", 6" ABOVE GROUND, FROM WHICH BEARS:

SET 5/8" REBAR WITH 2 1/2" AC STAMPED "T37S R3E C-C N 1/16 S4 PLS 77662 2022", 6" ABOVE GROUND, FROM WHICH BEARS:

(1338.63' R1)
(1341.12' R4)
(1320' R7)
(1338.50' CLC)

12" WF SCRIBED "XBT" S65°E 12.6' (NEW BT)
36" DF WITH HB N89 1/4°W 13.6' F (S60°W 14.52' R4)
3/4" GIP RS 404 PER R4 N1 1/2°W 6.69' MONUMENT REJECTED IN AGREEMENT WITH R1 & R2.

S 1/2 NE 1/4 SEC. 4

13" DF SCRIBED "XBT" N39 1/4°W 14.3' (NEW BT)
22" DF WITH HB S44°E 16.2' F (S46°E 18.48' R4)
3/4" GIP PER R4 N41 3/4°W 2.27' MONUMENT REJECTED IN AGREEMENT WITH R1 & R2.

(1315.27' CLC)
(1314.94' R1)
(1314.72' R4)
(1320' R7)

SISKIYOU TIMBERLANDS, LLC
D.N. 2020-000734
373E04 T.L. 1000

32" DF WITH HB S89 3/4°W 50.1' F (S89°49'W 49.60' R2)
30" DF WITH HB N45 3/4°E 34.9' F (N46°12'E 35.06' R2)
25" DF WITH HB N 5 1/2°E 91.8' F (S5°44'W 91.59' R2)

CENTER 1/4 CORNER OF SECTION 4, T.37S. R.3E.:

FOUND 2" I.D. GIP WITH 2 1/2" BC STAMPED "T37S R3E 1/4 S4 S3 1981 LS 1071", 12" ABOVE GROUND IN A 2' MOS, PER R2. FROM WHICH BEARS:

SURVEY NARRATIVE:

- 19" IC WITH HB S29 1/2°E 39.3' F (S29°34'E 39.50' R2)
- 17" DF SNAG WITH HB N67 1/4°W 22.7' F (N66°53'W 22.60' R2)
- 13" DF STUMP WITH VS N19°W 46.5' F (N18°06'W 46.30' R2)
- 18" DF D&D N5°E 33.8' F (N6°45'E 32.30' R2)
- 13" DF SNAG WITH HB S70 1/4°E 13.2' F (S71°27'E 13.70' R2)
- 1 1/4" GIP RS404 N25 1/4°W 2.65' F (N18°01'49"W 2.44' R2)


THE PURPOSE OF THIS SURVEY IS TO POST AND BLAZE THE LINES SHOWN IN BOLD HEREON. LINE TREES AND TREES ON BOTH SIDES OF THE BOLD LINES WERE QUARTER-BLAZED THIS SURVEY.

USING FOUND AND CALCULATED MONUMENTS AS SHOWN, I SUBDIVIDED SECTION 4 PER THE BLM 2009 MANUAL OF INSTRUCTIONS IN ORDER TO DELINEATE THE BOUNDARIES BETWEEN LANDS DESCRIBED IN DEEDS FOR TAX LOT 373E04 1000 AND TAX LOTS 373E04 400, 500, 600, & 800. (D.N. 2020-000734 AND D.N.S. 96-42078, 00-28967, & 2017-015195).

THIS SURVEY WAS CONDUCTED USING A TOPCON GTS 3003W TOTAL STATION AND TOPCON HIPER & GR3 GPS RECEIVERS. THE FIELD SURVEY COMMENCED JUNE 27, 2022 AND WAS COMPLETED JUNE 28, 2022.

THE BASIS OF BEARINGS FOR THIS SURVEY IS GEODETIC (NAD83), AT THE SOUTHWEST CORNER OF SECTION 32, T.36S., R.3E., PER R3, BASED ON STATIC GPS OBSERVATIONS TO CONTINUOUSLY OPERATING REFERENCE STATIONS (EPOCH 2011).

ALL FIELD BEARINGS AND DISTANCES TO BEARING TREES ARE TO THE CENTER OF THE TREE AT THE GROUND.

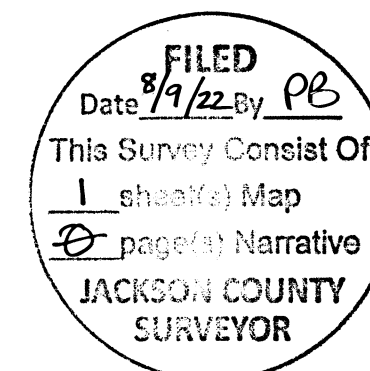

MAP OF SURVEY

FOR
SISKIYOU TIMBERLANDS, LLC
THE NORTH LINE OF THE S1/2 OF THE NE 1/4 OF SECTION 4, T.37S., R.3E., W.M. JACKSON COUNTY, OREGON

NORTH STATE LAND SURVEYING
4631 N. OLD STAGE ROAD
MOUNT SHASTA, CA
JULY 9, 2022 SCALE: 1"=300' SHEET 1 OF 1
HEPPMAP.ASC GOATMOS.GXD JOB NO. 770 DB: A.B.