


EXHIBIT "A"

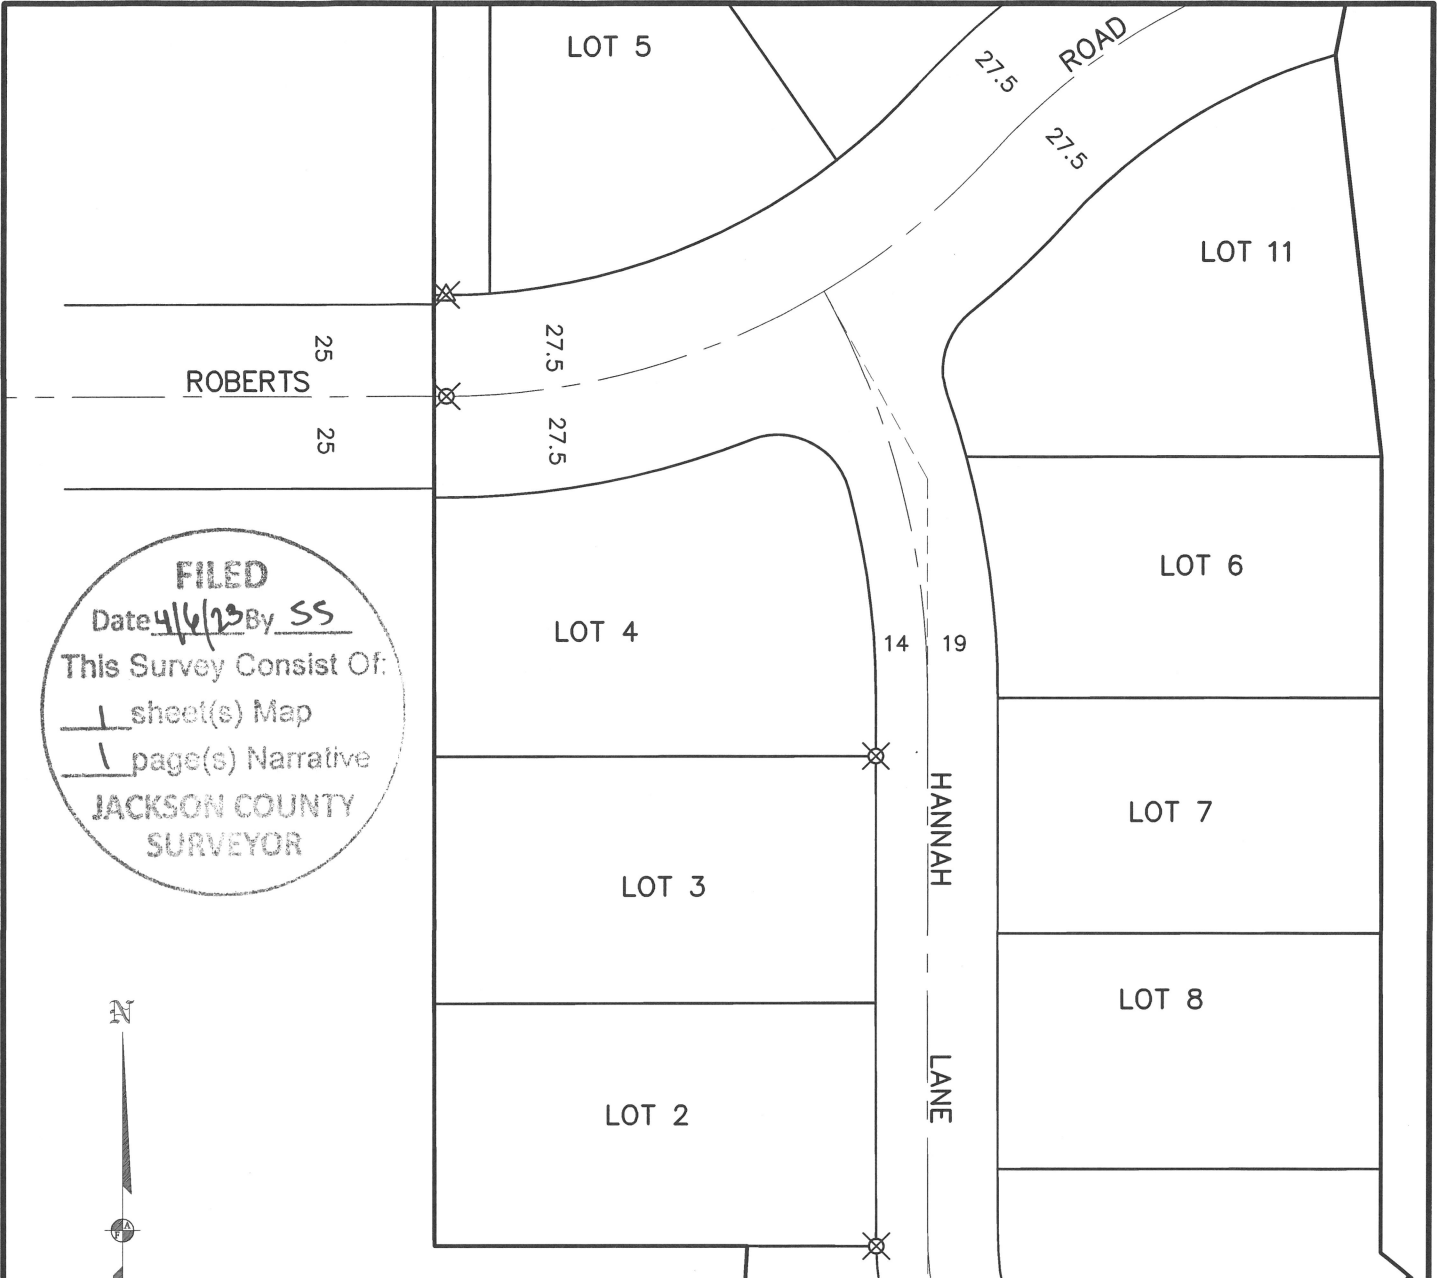

FILED
 Date 4/6/23 By SS
 This Survey Consist Of:
1 sheet(s) Map
1 page(s) Narrative
JACKSON COUNTY
SURVEYOR



LEGEND:

- ⊗ = SET 1.5" BERNSTEN COPPER MONUMENT IN CONCRETE.
- ⊗ = SET 2.5" BRASS WASHER MKD. L.J. FRIAR & ASSOC & MAG SPIKE IN ASPHALT.

REGISTERED PROFESSIONAL LAND SURVEYOR  OREGON JULY 17, 1986 JAMES E. HIBBS 2234 RENEWAL DATE 6-30-23	TITLE: POST MONUMENTATION EXHIBIT ASSESSOR'S MAP #: WILKSHIRE TERRACE, PHASE 1	DATE: 20 AUG 2022
	FOR: GALPIN HOMES, LLC 744 CARDLEY AVE., #100 MEDFORD, OR 97504	SCALE: 1 inch = 50 feet
© L.J. FRIAR & ASSOCIATES, P.C. 2022	 L.J. FRIAR & ASSOCIATES P.C. CONSULTING LAND SURVEYORS P.O. BOX 1947, PHOENIX, OR 97535 (541) 772-2782 lfriarandassociates@charter.net	ORIGIN: ROTATION: 0° JOB#: 18119FM
		Sheet 4 of 4