

LEGEND OF SYMBOLS

⊕ FOUND MONUMENT DESCRIBED.

ABBREVIATIONS USED

D.N. = DOCUMENT NUMBER  
T.L. = TAX LOT  
CS = MAP OF SURVEY

REFERENCES:

R1 = CS 10757  
R2 = CS 9433  
R3 = CS 23663  
R4 = BUREAU OF LAND MANAGEMENT  
REMONUMENTATION NOTES OF  
T.33S., R.2W., W.M., SURVEY  
COMPLETED ON AUGUST 10, 1966.

SURVEY NARRATIVE:

THE PURPOSE OF THIS SURVEY IS TO RETRACE THE LINES SHOWN IN BOLD, AND TO MARK THESE LINES ON THE GROUND.

USING FOUND MONUMENTS AS SHOWN, I RETRACED THE LINES SHOWN IN BOLD AS FIRST ESTABLISHED PER CS 10757.

THIS SURVEY WAS CONDUCTED USING A TOPCON GTS 3003W TOTAL STATION. THE FIELD SURVEY COMMENCED MAY 31, 2023 AND WAS COMPLETED JUNE 1, 2023.

BASIS OF BEARINGS IS THE SOUTH LINE OF THE NORTH 1/2 OF THE NORTHWEST 1/4 OF SECTION 22 AS SHOWN PER R1 BETWEEN FOUND CORNERS: = N 89°50'57"W.

ALL FIELD BEARINGS AND DISTANCES TO BEARING TREES ARE BY COMPASS AND TAPE.

SISKIYOU  
TIMBERLANDS LLC  
D.N. 2019-7511  
T.L. 2300

U.S.A.  
D.N. 87-22825  
T.L. 2200

SISKIYOU  
TIMBERLANDS LLC  
D.N. 2019-7511  
T.L. 3500

SISKIYOU  
TIMBERLANDS LLC  
D.N. 2019-7511  
T.L. 3900

JOHN HANCOCK LIFE  
INSURANCE COMPANY  
D.N. 2017-10772  
T.L. 3600

NORTH 1/2 OF THE  
NORTHWEST 1/4 OF  
SECTION 22

N 0°29'34"W 1328.275' = R1  
N 0°30'18"W 1328.61'

N 89°50'57"W 2663.28'  
N 89°50'57"W 2662.62' = R1  
BASIS OF BEARINGS


FOUND 5/8" DIAMETER REBAR, WITH NO CAP, AND BENT AT THE TOP, PER CS 9433 FROM WHICH BEARS:

- 1. 10" DIAMETER DOUGLAS FIR, DEAD AND DOWN, WITH HEALED BLAZE, S 20°E, 26.2' - RECORD = FIELD
- 2. 30" DIAMETER INCENSE CEDAR, WITH HEALED BLAZE, N 74°W, 26.9' - RECORD = FIELD

FOUND 5/8" DIAMETER REBAR WITH PLASTIC CAP STAMPED "PLS 944" PER CS 10757 FROM WHICH BEARS:

- 1. 14" DIAMETER DOUGLAS FIR, WITH HEALED BLAZE, N 80°E, 31.5' - RECORD = FIELD
- 2. 14" DIAMETER INCENSE CEDAR, WITH HEALED BLAZE, N 22°W, 16.6' - RECORD = FIELD

SISKIYOU  
TIMBERLANDS LLC  
D.N. 2019-7511  
T.L. 3700

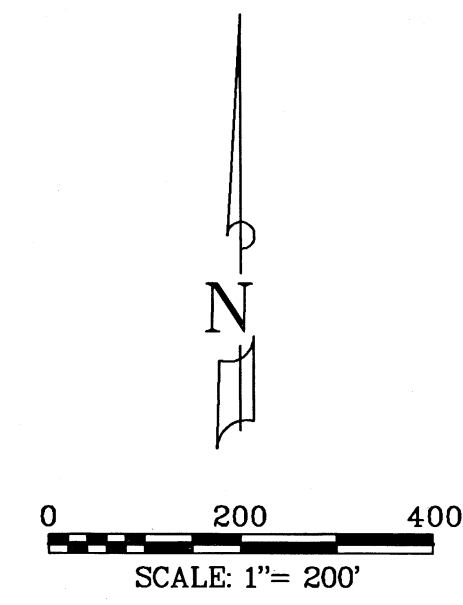

REGISTERED  
PROFESSIONAL  
LAND SURVEYOR

OREGON  
JULY 11, 2006  
GREGG ARNOLD NEITSCH  
77662LS

EXPIRES: 12/31/2024

MAP OF SURVEY

FOR

JOHN HANCOCK LIFE  
INSURANCE COMPANY

LOCATED IN THE NORTH 1/2 OF THE  
NORTHWEST 1/4 OF SECTION 22,  
T. 33 S., R. 2 W., W.M.,  
JACKSON COUNTY, OREGON

NORTH STATE LAND SURVEYING  
4631 NORTH OLD STAGE ROAD  
MOUNT SHASTA, CA

MAY 2023 SCALE: 1" = 200' SHEET 1 OF 1  
WALPOLE.ASC WALPOLE.GXD JOB NO. 846 DB: AM

