

TERBECK  
D.N. 2015-012855  
TAX MAP 33 1E  
T.L. 9900

U.S.A.  
TAX MAP 33 2E 31  
T.L. 200

SISKIYOU  
TIMBERLANDS LLC  
D.N. 2020-027831  
TAX MAP 34 1E  
T.L. 100

SILVER BUTTE  
TIMBER CO.  
D.N. 97-21819  
TAX MAP 34 2E  
T.L. 1000

SISKIYOU  
TIMBERLANDS LLC  
D.N. 2020-027831  
TAX MAP 34 1E  
T.L. 4300

SISKIYOU  
TIMBERLANDS LLC  
D.N. 2020-027831  
TAX MAP 34 2E  
T.L. 1100

**REFERENCES:**

- R1 = CS SECOND RE-ESTABLISHMENT GCDB 100640 (CS 1990)
- R2 = BUREAU OF LAND MANAGEMENT PLAT AND NOTES OF DEPENDENT RESURVEY AND SUBDIVISION OF SECTION 7, T.34S., R.2E., W.M., SURVEY DATED AUGUST 9, 2016.
- R3 = CS 2482 (CORNER RECORD BY DUANE A. SMELTZER, RS 461 IN 1964)
- R4 = CS FIRST RE-ESTABLISHMENT GCDB 100100 (CS 1988)
- R5 = GLO PLAT AND FIELD NOTES FOR T.34S., R.2E., W.M., APPROVED JULY 7, 1856.
- R6 = CS 4766
- R7 = CS 22053

**LEGEND OF SYMBOLS**

- FOUND MONUMENT AS DESCRIBED IN CORNER NOTES.

**ABBREVIATIONS USED**

- D.N. = DOCUMENT NUMBER
- T.L. = TAX LOT
- CS = COUNTY SURVEY (SURVEYOR)
- JCS = JACKSON COUNTY SURVEYOR
- DIA = DIAMETER
- IDIA = INSIDE DIAMETER
- ODIA = OUTSIDE DIAMETER
- BC = BRASS CAP
- BLM = BUREAU OF LAND MANAGEMENT
- GLO = GENERAL LAND OFFICE
- DF = DOUGLAS FIR
- WF = WHITE FIR
- IC = INCENSE CEDAR
- BT = BEARING TREE
- FWB = FROM WHICH BEARS
- WHB = WITH HEALED BLAZE
- WVS = WITH VISIBLE SCRIBING
- D&D = DEAD AND DOWN
- IP = IRON PIPE
- GIP = GALVANIZED IRON PIPE
- SSP = STAINLESS STEEL PIPE

**CORNER NOTES**


**CORNER 1.**  
SECTION CORNER S1, S6, S31, AND S36  
T.33S., T.34S, R.1E, R.2E., W.M.  
FND 2" IDIA IP WITH 2" DIA BRASS CAP  
STAMPED "CS 1988"  
AND "RS461", FWB:  
1. 29" DIA WF, WHB, N 40°14'E, 29.7'  
(14" DIA WF, N 40°E, 29.5'= R3)  
(19" DIA WF, WHB, N 40°E, 29.65'= R4)  
2. 10" DIA DF, WHB, D&D, S 76°21'E, 8.0'  
(8" DIA WF, S 76°E, 7.4'= R3)  
(10" DIA DF, WHB, S 76°E, 8.0'= R4)  
3. 8" DIA IC, NEW BT, S 66°32'E, 8.6'  
4. 12" DIA DF STUMP, WHB, N 42°48'W, 14.5'  
(11" DIA DF, N 44°W, 14.3'= R3)  
(11" DIA DF, WHB, N 41°30'W, 14.55'= R4)  
5. 7" DIA WF, NEW BT, N 15°50'W, 8.7'  
6. 10" DIA DF, WVS, D&D, S 56°28'W, 37.0'  
7. 18" DIA DF, NEW BT, S 66°53'W, 62.0'  
NOTE: NEW BT'S SCRIBED "XBT"

**CORNER 2.**  
1/4 CORNER S1 AND S6  
T.34S, R.1E, R.2E., W.M.  
FND 1" ODIA GIP WITH A 2.5" DIA BC SET  
BY JCS IN 1990 STAMPED "CS 1990", FWB:  
1. 24" DIA DF STUMP, S 2°03'E, 7.0'  
(28" DIA FIR STUMP, SOUTH, 7.1'= R1)  
2. 24" DIA DF STUMP, WITH ROTTED BLAZE, S 16°20'E, 9.5'  
(21" DIA FIR STUMP, S 16°E, 8.9'= R1)  
3. 27" DIA WF STUMP, WHB, N 1°10'W, 9.4'  
(16" DIA DF, WHB, NORTH, 9.2'= R1)  
4. 14" DIA IC, WHB, N 52°10'W, 10.3'  
(6" DIA CEDAR, N 48°30'W, 10.45'= R1)  
5. 13" DIA IC, WHB, S 28°24'W, 7.4'  
(6" DIA CEDAR, S 32°W, 7.5'= R1)  
6. 19" DIA WF, WHB, S 77°57'E, 45.9'  
(8" DIA DF, S74°30'E, 45.85'= R1)

**CORNER 3.**  
SECTION CORNER S1, S6, S7, AND S12  
T.34S, R.1E, R.2E., W.M.  
FND 3.25" BC ON 2.5" ODIA SSP SET BY BLM  
IN 2015, FWB:  
1. 24" DIA IC, WHB, S 84°30'W, 7.1'  
(20" DIA CEDAR, WHB, S 81°30'W, 7.1'= R2)  
2. 20" DIA IC, WHB, S 56°36'E, 12.1'  
(16" DIA CEDAR, WHB, S 56°45'E, 11.8'= R2)  
3. 20" DIA WF, WHB, N 78°00'E, 17.8'  
(16" DIA FIR, WHB, N78°15'E, 17.7'= R2)  
4. 30" DIA DF, WHB, N 28°51'W, 20.4'  
(26" DIA FIR, WHB, N 31°W, 20.5"= R2)

**SURVEY NARRATIVE:**

THE PURPOSE OF THIS SURVEY IS TO RETRACE THE LINE SHOWN IN BOLD, AND TO MARK THIS LINE ON THE GROUND.  
USING FOUND MONUMENTS AS SHOWN, I RETRACED THE LINE SHOWN IN BOLD AS FIRST ESTABLISHED PER THE ORIGINAL GLO SURVEY OF 1854. GLO LINES TREES ALONG THIS LINE WERE SEARCHED FOR, BUT NONE WERE RECOVERED.  
THIS SURVEY WAS CONDUCTED USING A TOPCON GTS 3003W TOTAL STATION AND TOPCON GPS RECEIVERS. THE FIELD SURVEY WAS COMMENCED MAY 25, 2023 AND WAS COMPLETED MAY 30, 2023.  
BEARINGS FOR THIS SURVEY ARE GEODETIC, CALCULATED BY USING DIFFERENTIAL LATITUDE AND LONGITUDE VALUES OF POINTS ALONG THE WEST LINE OF SECTION 6. THESE VALUES WERE FIELD DETERMINED BY DIFFERENTIAL STATIC GPS OBSERVATIONS (NAD 83 2011, EPOCH 2010).

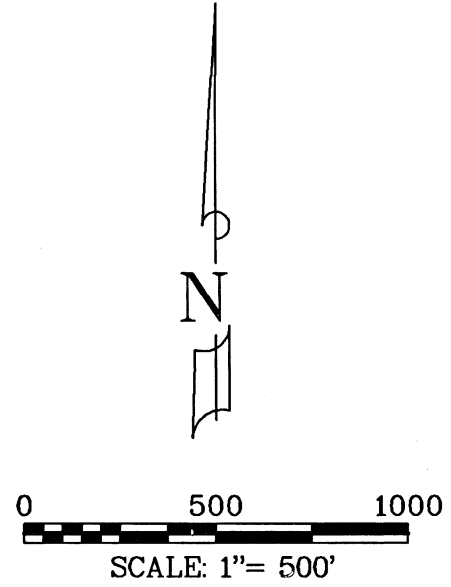

REGISTERED  
PROFESSIONAL  
LAND SURVEYOR  
*Greg Arnold Neitsch*  
OREGON  
JULY 11, 2006  
GREGG ARNOLD NEITSCH  
77662LS  
EXPIRES: 12/31/2024

**FILED**  
Date 7/18/23 By PB  
This Survey Consist Of:  
1 sheet(s) Map  
1 page(s) Narrative  
**JACKSON COUNTY  
SURVEYOR**

**MAP OF SURVEY**

FOR  
**SILVER BUTTE TIMBER CO.**

LOCATED IN SECTION 6,  
T. 34 S., R. 2 E., W.M.,  
JACKSON COUNTY, OREGON

NORTH STATE LAND SURVEYING  
4631 NORTH OLD STAGE ROAD  
MOUNT SHASTA, CA

JUNE 2023 SCALE: 1"= 500' SHEET 1 OF 1  
S634S2E.ASC CLARK CREEK MS.GXD JOB NO. 828 DB: AM