
ASSESSOR'S PLAT NO.: 391E09CA13600

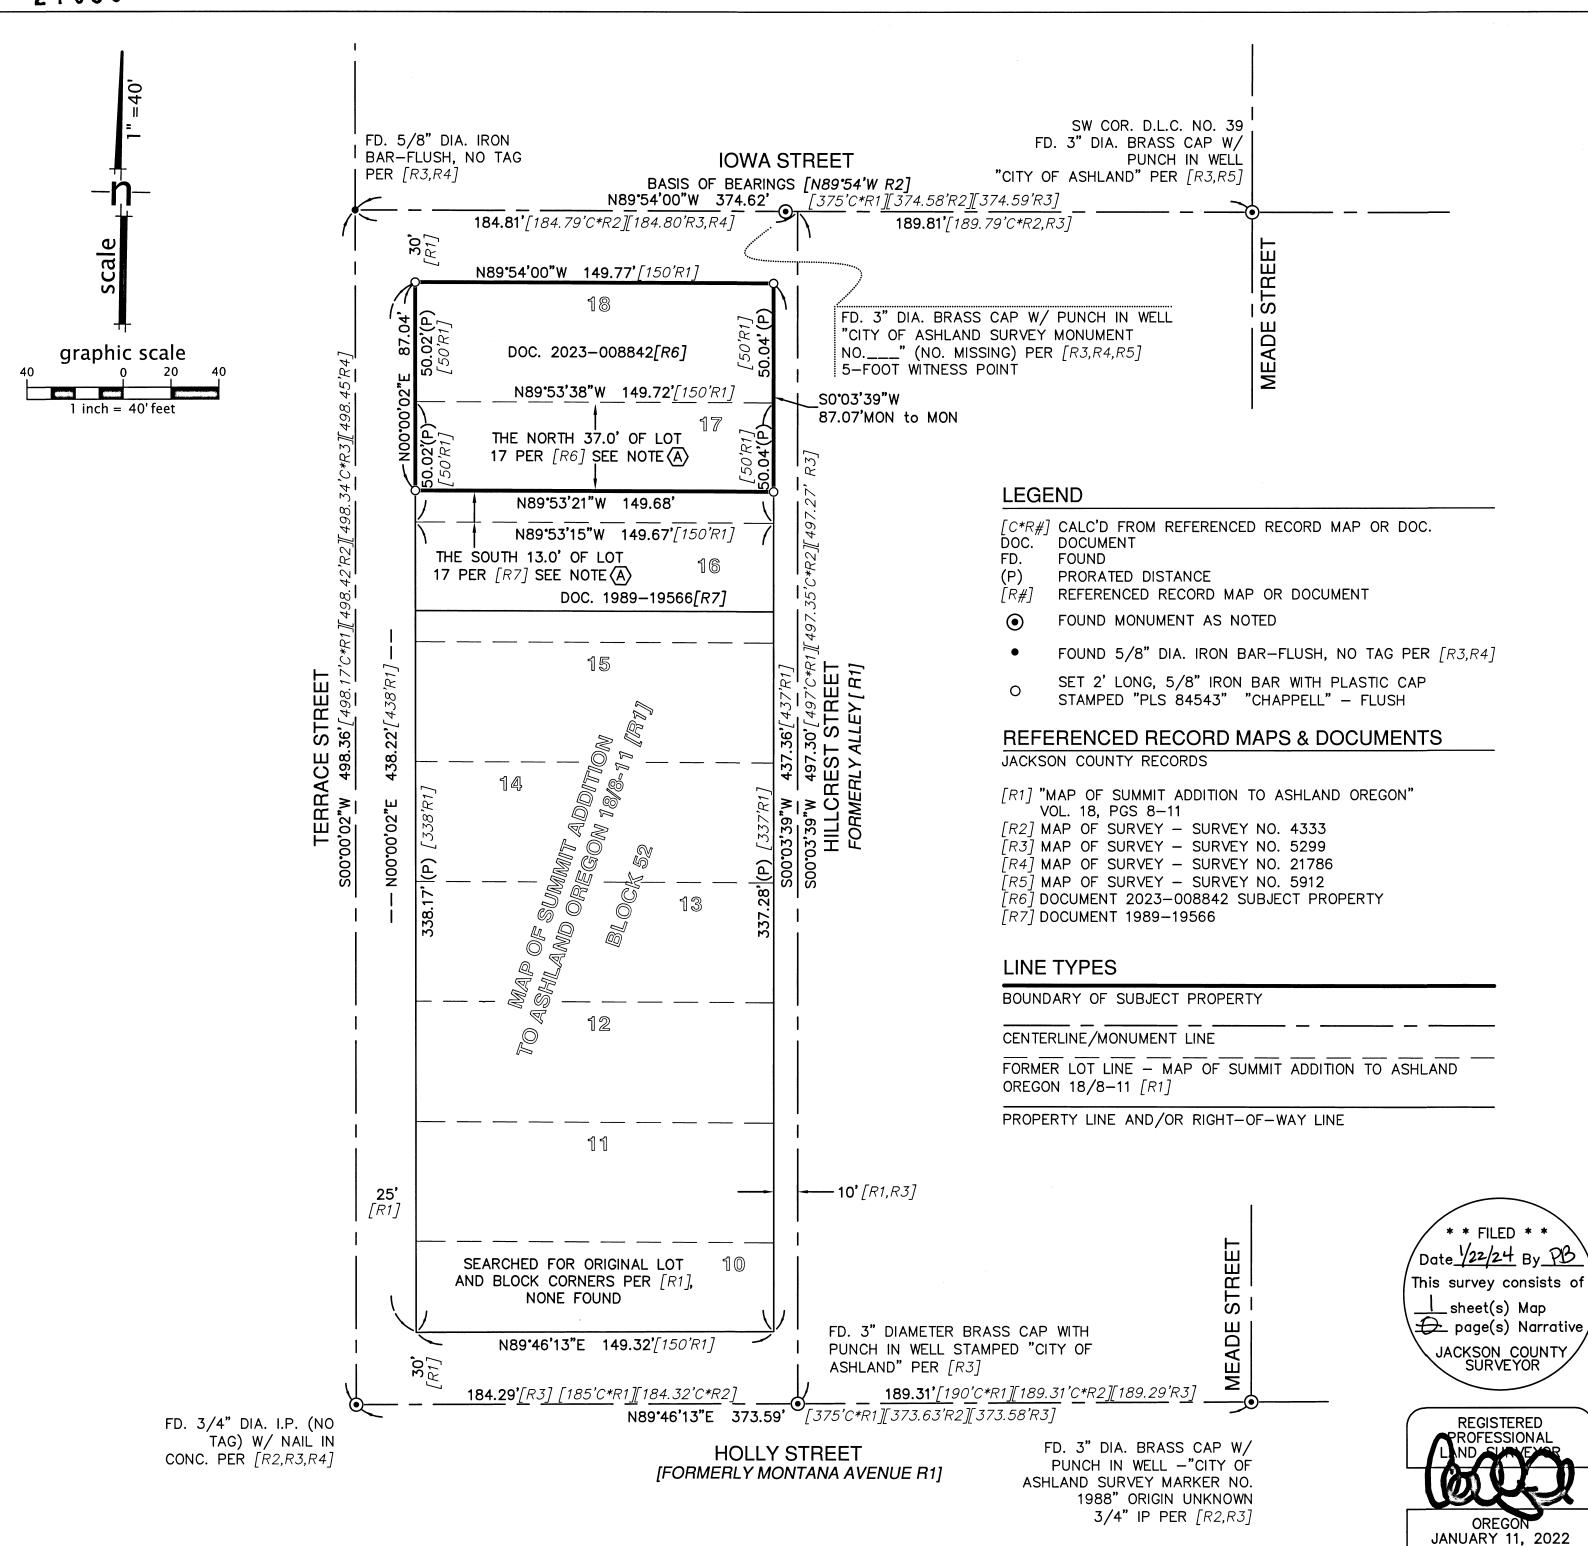

MAP OF SURVEY

LOCATED WITHIN
THE SOUTHWEST QUARTER OF SECTION 9,
TOWNSHIP 39 SOUTH, RANGE 1 EAST,
WILLAMETTE MERIDIAN
CITY OF ASHLAND JACKSON CO., OREGON

FOR MORIAZ BERNARD M & JENSEN CHRISTINA A REV TRUST 249 HILLCREST STREET, ASHLAND, OR 97520

BASIS OF BEARINGS

THE BEARING OF NORTH 89° 54' WEST, BEING THE MONUMENTED CENTERLINE OF IOWA STREET, AS SHOWN ON SURVEY MAP NO. 4333[R3], FILED FOR RECORD AT THE JACKSON COUNTY SURVEYOR'S OFFICE, WAS USED AS THE BASIS FOR ALL BEARING SHOWN HEREON.

GENERAL NOTES

- 1. ALL REFERENCES ARE TO JACKSON COUNTY RECORDS.
- 2. ALL DISTANCES ARE MEASURED UNLESS OTHERWISE NOTED. WHEN A MEASURED DISTANCE NOTES A RECORD REFERENCE IN ITALICS, i.e. [R#], THE DISTANCE IS BOTH MEASURED AND RECORD.

SURVEY NARRATIVE TO COMPLY WITH O.R.S. 209.250

PURPOSE

TO SURVEY AND MONUMENT THAT PIECE OF LAND RECORDED AS INSTRUMENT NUMBER 2023-008842, OFFICIAL RECORDS OF JACKSON COUNTY, OREGON, PER THE REQUEST OF THE CLIENT.

PROCEDURE

UTILIZING A TRIMBLE S-7 TOTAL ROBOTIC STATION AND A TRIMBLE TSC3 DATA COLLECTOR WE SURVEYED EXISTING MONUMENTATION AND PHYSICAL FEATURES WITHIN BLOCK 52 OF THE SUMMIT ADDITION TO ASHLAND OREGON OFFICIAL 1888 MAP WHICH IS BOUND BY TERRACE STREET, IOWA STREET, MEADE STREET, AND HOLLY STREET.

THE MONUMENTS AT THE CENTERLINE INTERSECTIONS OF TERRACE STREET, IOWA STREET, MEADE STREET, HILLCREST STREET, AND HOLLY STREET WERE FOUND AND ACCEPTED TO ESTABLISH THE STREET CENTERLINES.

THE RESOLVED CENTERLINES WERE OFFSET THE RECORD STREET HALF-WIDTHS TO CREATE THE BOUNDARY OF SAID BLOCK 52.

THE LOT LINES FOR LOT 10 THROUGH LOT 18, BLOCK 52 OF THE SUMMIT ADDITION TO ASHLAND OREGON OFFICIAL 1888 MAP WERE ESTABLISHED BY PRORATION.

REGARDING THE SOUTHERLY LINE OF THE SUBJECT PROPERTY: THE SUBJECT PROPERTY'S DEED (DOCUMENT 2023-008842[R6]) INCLUDES THE NORTH 37.0 FEET OF LOT 17. THE ADJOINING DEED TO THE SOUTH (DOCUMENT 1989-19566[R7]), INCLUDES THE SOUTH 13.0 FEET OF LOT 17. DUE TO AN EXCESS IN BLOCK 52 IN THE NORTH-SOUTH DIRECTION, A 0.03' TO 0.04' GAP WOULD BE CREATED BY USING PARALLEL OFFSETS FROM THE RESPECTIVE NORTH AND SOUTH LINES OF LOT 17. WE BELIEVE IT WAS NOT THE INTENT TO CREATE A GAP BETWEEN THE TWO LOTS AND AS SUCH, WE ESTABLISHED THE COMMON LINE VIA PRORATION.

SURVEYED BY



PACIFIC CREST SURVEYING

131 Helman Street Ashland, Oregon 97520 (408) 375-5220

SHEET 1 OF 1
DATE: SEPTEMBER 12, 2023
PCS PROJECT NO. 2023057

CURT C. CHAPPELL 84543 PLS