

SURVEY NARRATIVE TO COMPLY WITH PARAGRAPH 209.250, OREGON REVISED STATUTES

FOR: ELK LUMBER COMPANY

PURPOSE: To rehabilitate and perpetuate the 1/4 section corner common to Sections 4 and 3, Township 32 South, Range 1 East, W. M.

PROCEDURE:

Found a stone of approximately record dimensions with no discernable markings, and the remains of the original BT's, both of which are dead and badly deteriorated. The Northwest BT is now a down 27 inch Douglas fir snag with markings obliterated by fire and decay. The original Southeast BT is now a 7 inch Madrone stub, badly decayed in heart but with reversed scribe "1/4 S" plainly legible in callus tissue over old face.

Corner positions as determined by record bearings and distances from the original BTs showed a variation of 2.3 feet, so used the mean of those two positions as the corner point and set a 1 inch by 36 inch galvanized steel pipe driven 24 inches in the ground and capped with a 1-1/2 inch to 1 inch galvanized bell reducer filled with pot metal and stamped as shown below in 1/8 inch letters and numerals:

1963

T 32 S R 1E

4/3

1/4 COR

RS 583


From this monument, a 26 inch Douglas fir, double blazed and scribed "RS 583" in the upper blaze and "BT" in the lower, bears North 36° East 58.3 feet; and a 32 inch Douglas fir, single blazed and scribed "RS 583 BT" bears South 1°30' East 38.8 feet.

Field work by R. Vincent and B. Brandt.

Compass variation 20°00' East.

Distances to face of blaze.

December 30, 1963.

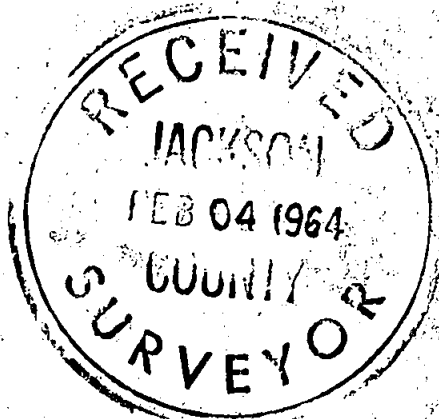

*Robert M. Vincent*

