


22 23  
27 26

23

26

R = 70.00'  
L = 56.99'  
LC = S74°55'55"E 55.43'

N.W. 1/4 SEC. 26

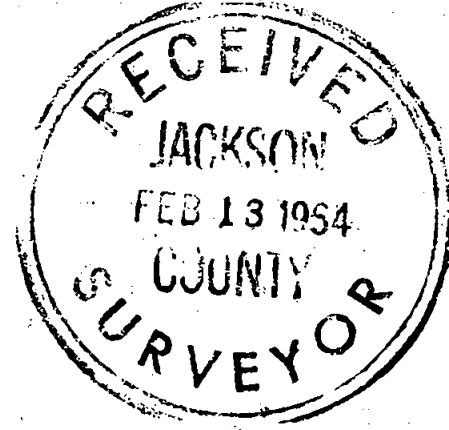

ORIENTED D/R BRG'S TO RIGHT 0°09'30"

REGISTERED  
**OREGON**  
LAND SURVEYOR  
*Leland P. Lovejoy*  
NOVEMBER 18, 1948  
LELAND P. LOVEJOY  
262

N0°00'30"E 1084.81' (REC. 1055.57')

FD. 5/8" IRON PINS  
SURVEY NO. 948

FD. 3/4" IRON PIPE  
N. 1.38' W. 1.43'

NORTH 42.94'

N0°00'30"E 539.73'

PARCEL "C"  
2.424 AC. ±

R = 388.10'  
L = 208.40'  
LC = S66°59'30"E 205.91'

TRAVELED  
S82°22'30"E 4779'

R = 208.73'  
L = 85.31'  
LC = S70°40'00"E 84.72'

PT. 1957  
POC.

N0°00'30"E 449.09'

PARCEL "B"  
2.045 AC. ±

S58°57'30"E 69.82'  
FD. 1" G.I. PIPE  
S. 0.56', W. 3.10'

R = 348.31'  
L = 58.33'  
LC = S83°45'20"E 58.26'

ROAD

N89°41'00"W 220.00'

S89°41'00"E 220.00'

PARCEL "A"  
2.020 A/C ±

S0°00'30"W 756.76'  
(REC. 749.33')

BOUNDARY SURVEY OF PROPERTY  
SITUATE IN  
N.W. 1/4 SECTION 26, T 37S., R. 1W., W.M.  
JACKSON COUNTY OREGON  
FOR  
R.W. GRAY

L.P. LOVEJOY L.S. MEDFORD, OREGON  
SCALE: 1" = 100' JAN. 13, 1964

BEARINGS PER SURVEY NO. 948  
◊ = SET 5/8" STEEL REINF. BAR

N/L CHERRY LANE

440.00'

CHERRY LANE

S89°41'00"E 660.00'

30.00'

FD. 3/4" IRON PIPE  
S. 0.09', W. 2.82'

SURVEY NARRATIVE TO COMPLY WITH SECTION 87-3301947 OREGON STATE LAWS

Survey For: R. W. Gray  
Bear Creek Orchards  
Medford, Oregon

Purpose of Survey: To divide land into three parcels  
and establish property boundaries

Survey Location: NW1/4 Sec. 26, T37S, R1W, W.M.,  
Jackson County, Oregon

Survey Procedure: Found D.L.C. corner and other survey  
monuments as shown on map and used  
as a basis for survey control. Set  
5/8" steel reinf. bars.

Leland P. Lovejoy  
Registered Land Surveyor

Work Completed: January 13, 1964

