


Survey For
 FAYDREX INC.
 Located in the SW 1/4 of Sec. 28,
 NE 1/4 & SE 1/4 of Sec. 32 and
 NW 1/4 & SW 1/4 of Sec. 33,
 T. 35 S., R. 1 W., W.M.
 By: Mark E. Boyden
 February 10, 1964

SCALE: 1" = 200'

- ✕ Set 5/8" x 30" iron pin with top 2" from surface of ground unless otherwise indicated
- Set 5/8" x 24" iron pin with top 2" from surface of ground unless otherwise indicated
- Found 5/8" iron pin

Basis of bearings: Recorded Survey No. 1692

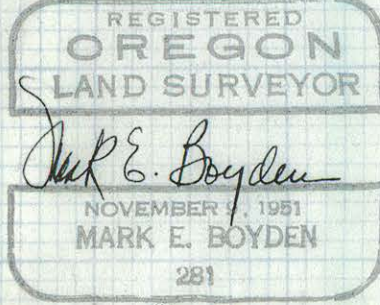

SURVEY NARRATIVE TO COMPLY WITH O.R.S. 209.250
REVISED BY CHAPTER 555, O.L. 1963

FOR: Faydrex, Inc.
1054 South Riverside Avenue
Medford, Oregon

PURPOSE: To monument and describe by metes and bounds, lots and roads shown hereon, after preliminary approval of said roads was granted by the Jackson County Planning Commission.

PROCEDURE:

Outside boundary control was established according to Recorded Survey No. 1692, with the exception of the North boundary of the South-half of the Southwest Quarter of Section 28.

This fractional section boundary was established by combining information from Recorded Survey Numbers 567, 1619 and 1692, and then calculating the legal protraction of Section 28.

From random traverse control points previously set for Recorded Survey Number 1692, traversed the roads shown hereon, and closed each loop against the outside boundary random traverse.

All loops calculated closed within 1 foot, the error of which was pro-rated by coordinate proportionment.

Calculated the true road and lot corner positions with respect to random traverse points, setting iron pins for control as shown.

At the South one-sixteenth Section corner common to Sections 28 and 29, chiseled a cross on a rock outcrop for corner, from which:

An 8" W.Oak, scribed "RS 281-BT" bears South $70\frac{1}{4}^{\circ}$ East, 54.0 feet to the face of the upper blaze;

An 8" B.Oak, scribed "RS 281-BT" bears North $42\frac{1}{2}^{\circ}$ East, 24.1 feet to the face of the upper blaze.

At the Center-South one-sixteenth Section corner of

Section 28, set a 1"x 36" galvanized iron pipe, 34" in the ground for corner, from which:

An 18" Y.Pine, scribed "RS 281-BT" bears South 20 1/2° West, 22.5 feet to the face of the upper blaze;

A 20" Y.Pine, scribed "RS 281-BT" bears North 74 3/4° West, 46.8 feet to the face of the upper blaze.

February 10, 1964

