


Survey For  
 ROBERT C. GAIL  
 Located in D.L.C. No. 39 and the  
 N.E. 1/4 of Sec. 21, T. 36S., R. 4W., W.M.  
 By : Mark E. Boyden  
 Feb. 17, 1964

2430

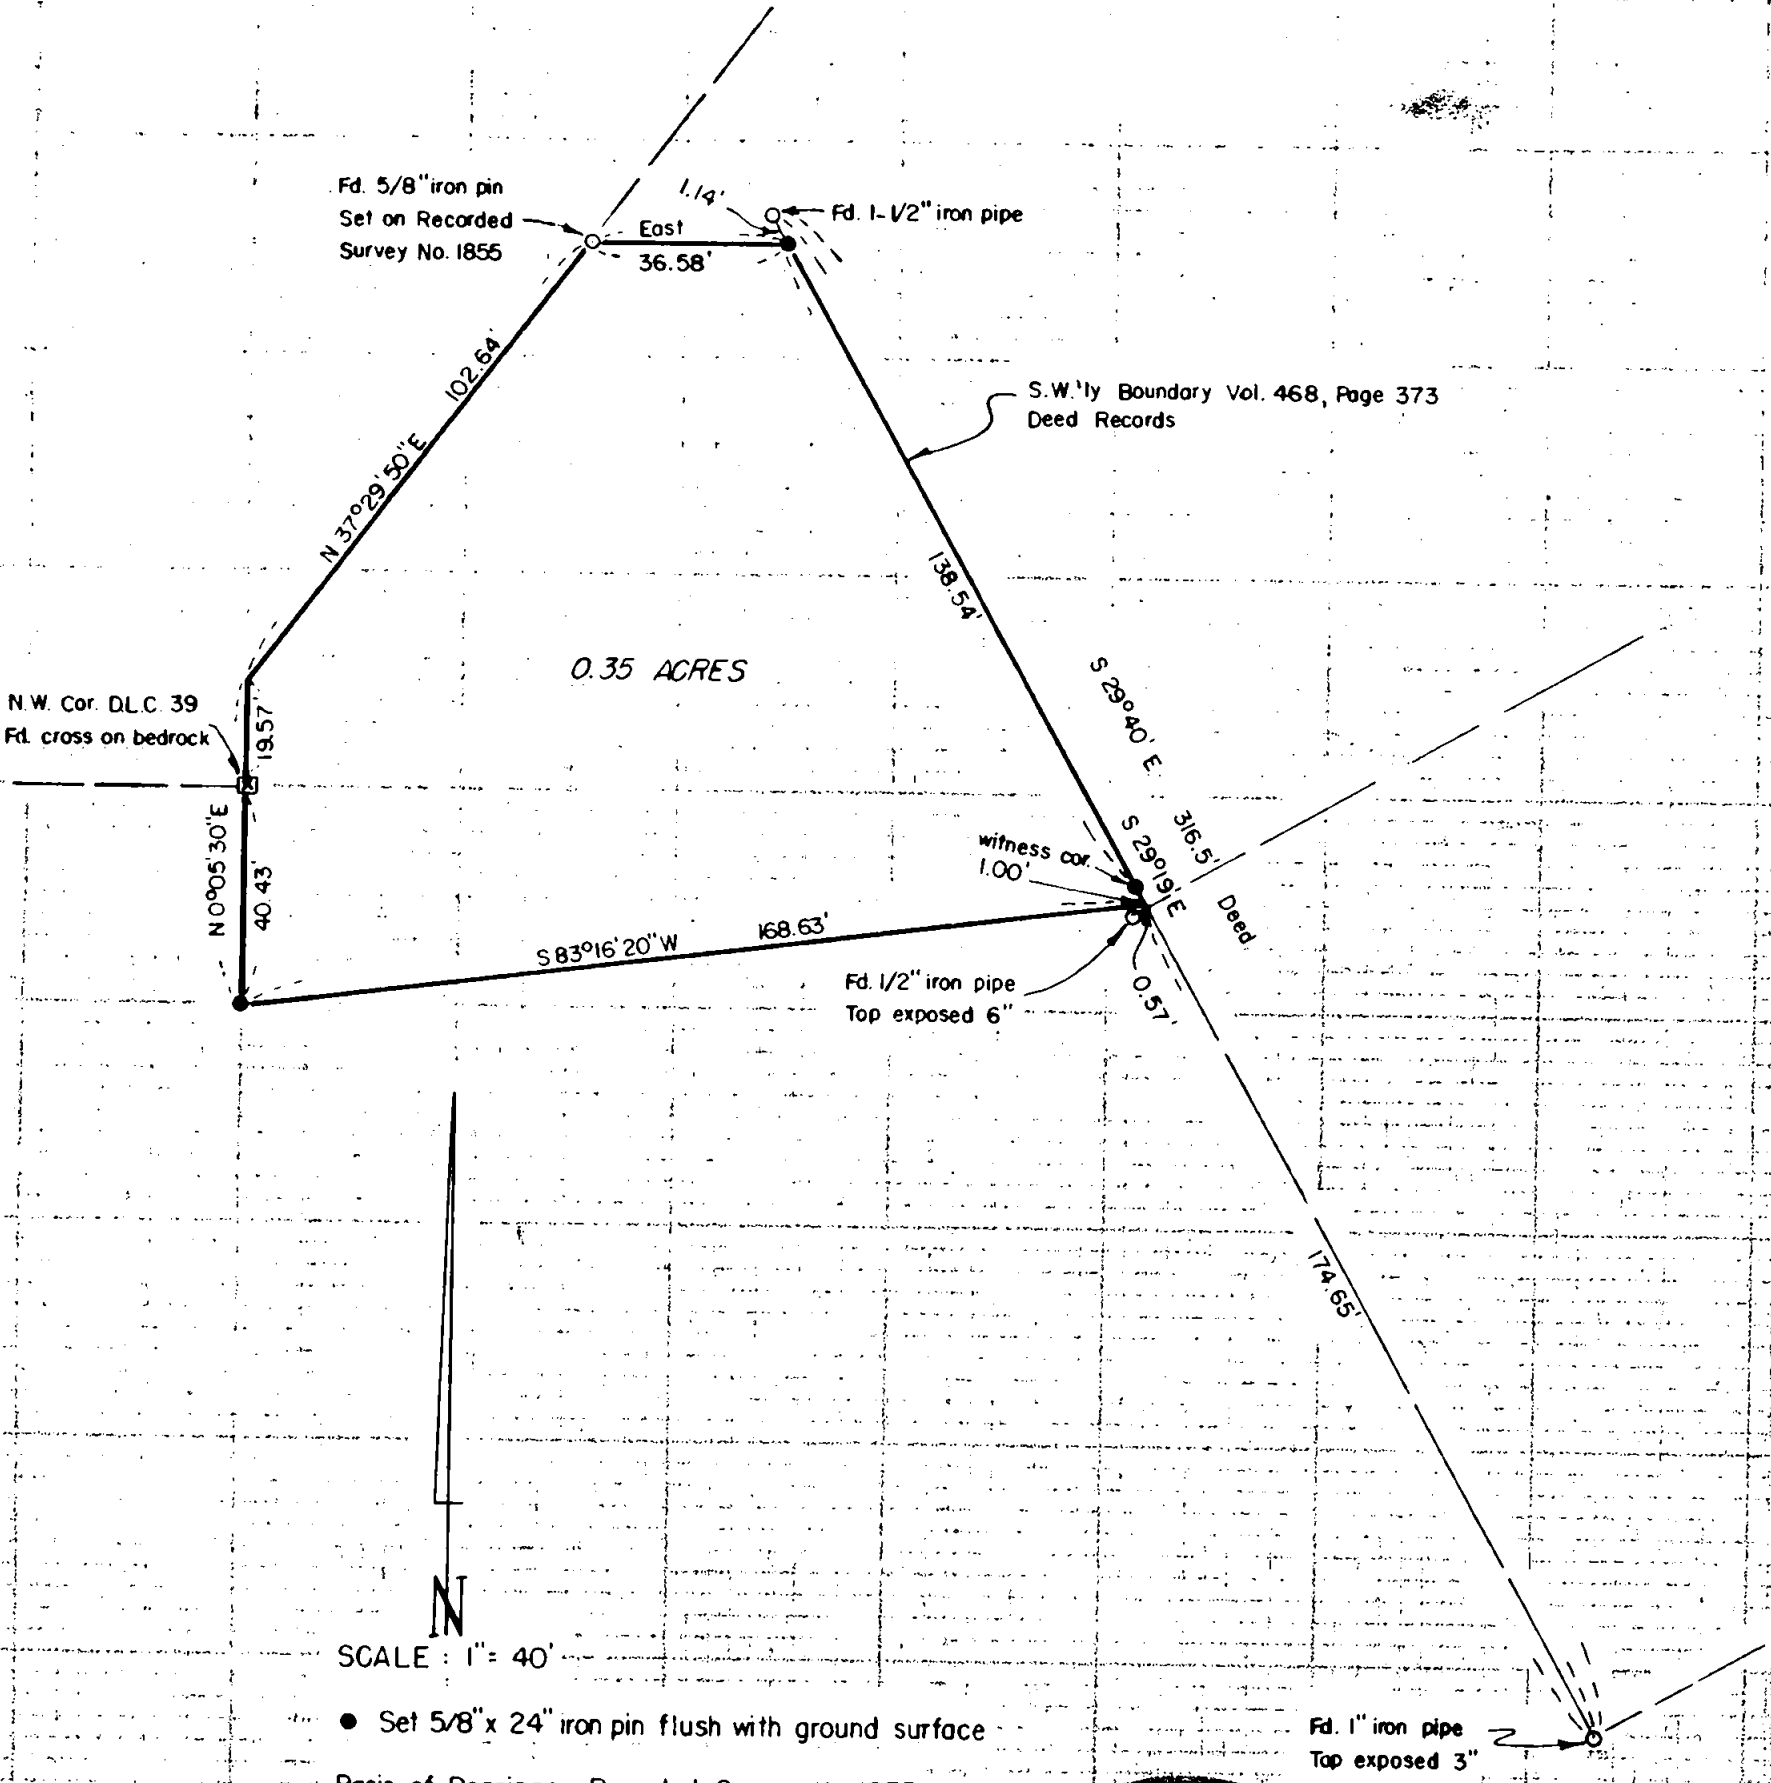

SCALE : 1" = 40'

- Set 5/8" x 24" iron pin flush with ground surface
- Basis of Bearings : Recorded Survey No. 1855

REGISTERED  
 OREGON  
 LAND SURVEYOR

*Mark E. Boyden*  
 NOVEMBER 9, 1951  
 MARK E. BOYDEN  
 281

RECEIVED  
 JACKSON  
 MAR - 2 1964  
 COUNTY  
 SURVEYOR

2430

Survey No. 2430

SURVEY NARRATIVE TO COMPLY WITH O.R.S. 209.250  
REVISED BY CHAPTER 555, O.L. 1963

FOR: Robert C. Gail  
Rt. 1, Box 382  
Gold Hill, Oregon

PURPOSE: To monument and describe a parcel in the Northerly portion of Babb property described in Volume 268, Page 403 less Volume 530, Page 383 of the Deed Records of Jackson County, Oregon.

PROCEDURE:

Found iron pipes set for control of the Southwesterly boundary of Volume 468, Page 373, Deed Records, said pipes were varified to be in their original position for the past 18 years by Mr. Babb.

Monumented the Southerly boundary of the subject parcel as agreed upon by the buyer (Mr. Gail) and the seller (Mr. Babb).

The remaining boundaries were monumented from controls previously set on Recorded Survey No. 1855.

February 17, 1964

