

Survey for Mrs. Hazel Holifield
 R 1 Box 300 Central Point, Oregon
 In NW 1/4 of SE 1/4 S 36
 T. 36 South, Range 3 W
 Jackson County, Oregon.
 Dated Jan 8, 1964
 Bearings are from County Road
 Solar were taken but no data for
 1964 available yet to compute them
 in time for this transaction.

REGISTERED
 OREGON
 LAND SURVEYOR
 L. N. DOW
 MAY 6, 1949
 251

RECEIVED
 JACKSON
 COUNTY &
 SURVEYOR
 MAR - 2 1964

South 424.89

Co. Road curve point center spike found



SCALE 1" = 100'

Co. Road Curve end center spike found

Narrative to accompany plat for Survey NO. 2432

Survey for Mrs. Hazel Holifield, R 1 Box 300 Central Point, Oregon.

Made January 8, 1964

Purpose to stake out one acre tract(inside)


Procedure: found a 5/8" bar with marker stake near the northerly boundary of Old Stage Road reported in filed survey NO 1696 as a 1" pipe, Could not find any evidence of 1" pipe, this point is S 69°56'E 99.97 feet and N 20°04'E 29.8 feet from the center line spike at the end of curve on Old Stage Road,

A tie was run to the Northwest corner of Donation Land Claim NO. 39, at which point a 3/4" bar was found.

A curve point in the center of Old Stage Road to the East of the first point mentioned was found and used as control for centerline of Old Stage Road.

With these controls we set 5/8" bars as shown on the plat.

Bearings used were County Road bearings. Solats were takes but at this time no Ephemeris was available to compute the data, (Jan 8th) and as County road bearings had been used previously for this area they were used for this survey, Also they are within approximately one minute of a bearing used on a re-establishment survey on file for the same area.

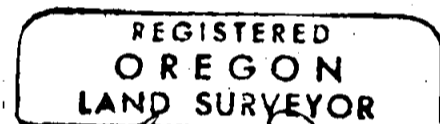

L. N. Dow

