
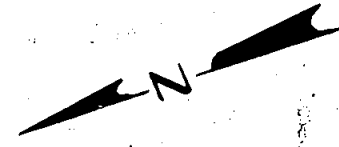


SURVEY OF LOTS 5, 11 & 12
BLOCK 35 ORIGINAL TOWN
JACKSONVILLE, OREGON

FOR
FRED BABBS
62-4

BY C. LIND MCBETH L.S. SCALE 1"=100'
JACKSONVILLE, OREGON • SET 5/8" I. PINS
SEPT. 1962 • FD NAIL

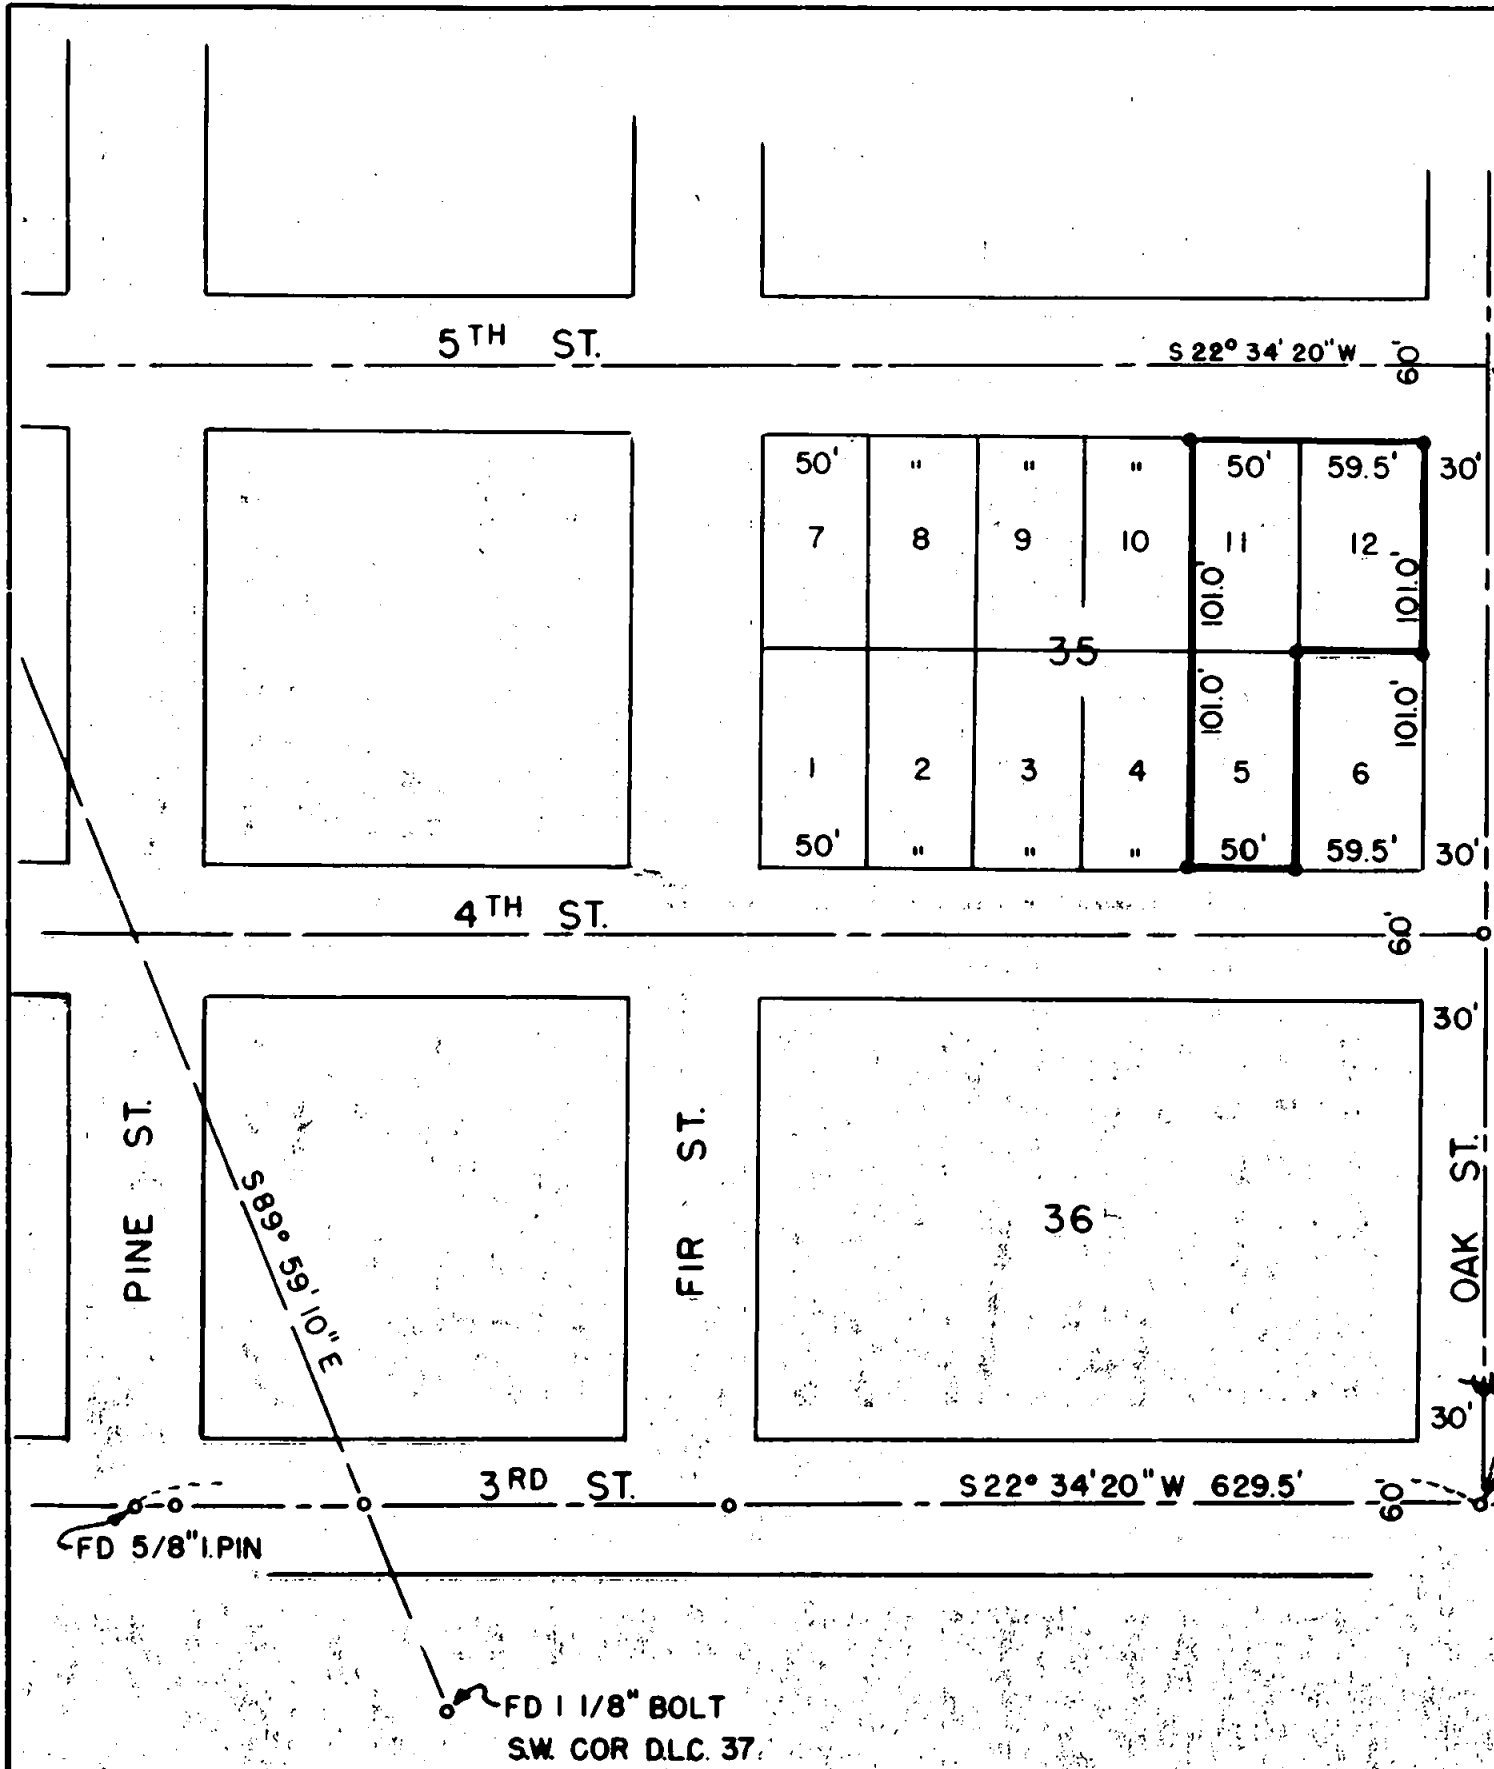

REGISTERED
OREGON
LAND SURVEYOR

C. Lind McBeth

JANUARY 12, 1962
C. LIND MCBETH
565

RECEIVED
JACKSON
MAR - 2 1964
COUNTY
SURVEYOR

Survey No. 2436

Survey Narrative to comply with ORS 209-250

Survey For: Mr. Fred Babbs
407 S. 4th St.
Jacksonville, Oregon

Basis of bearing: Previous Survey #2132

Date: Feb. 12, 1964

Procedure of Survey:

I found a 5/8" Iron Pin at the centerline intersections of Third and Pine Streets, City of Jacksonville, from records of Survey #2132. Then I chained Southwesterly along the centerline of Third Street to intersect the centerline of Oak St. At this point, I set a 3/4" x 30" Iron Pin, as shown. Then produced record distance Southeasterly along centerline of Oak and set 5/8" Iron Pins on the corners of lots 5, 11, and 12, Block 35 O.T., as requested by the client.

62-4

REGISTERED
OREGON
LAND SURVEYOR

C. Lind McBeth

JANUARY 12, 1959
C. LIND MCBETH
565

RECEIVED
JACKSON
MAR - 2 1964
COUNTY
SURVEYOR