


SCALE 1" = 100'

LEGEND
 O Fd. 5/8" PIN
 X-X FENCE LINE

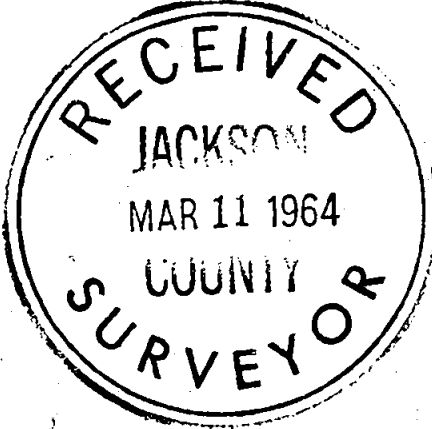

REGISTERED
 OREGON
 LAND SURVEYOR

Charles H. Hurst

OCTOBER 30, 1989
 CHARLES H. HURST
 483

SURVEY FOR
HENRY DE VOSS
 LOCATED IN DLC 67
 SECTION 35, T. 38 S., R. 1 W., W.M.
 BY: CHARLES H. HURST
 FEB. 10, 1964

APPROXIMATE $\frac{1}{2}$ T.I.D. WEST LATERAL
 D.R. 501, PG. 45-46

EAST EDGE OF R/W

INITIAL POINT - ESE COR. D.L.C. 67
 Fd. 1 1/2" PIPE

Survey narrative to comply with O.R.S. 209.250

Survey for: Henry DeVoss
Rte. 1, Box 589
Talent, Oregon

Survey by : Charles H. Hurst
765 Sunrise Avenue
Medford, Oregon

Purpose of survey: To locate the T.I.D. canal for purposes
of description

Procedure of survey:

Found the ESE corner of DLC 67, traversed therefrom westerly to the T.I.D. canal, thence along approximate centerline of said canal northerly closing on line established during recorded survey No. 1953 as shown on the attached plat.

Basis of bearing: Recorded survey No. 1953

Survey completed:

February 10, 1964

