

SURVEY IN NW. 1/4 SEC. 29 T 36 S. R. 1 W. W.M.
 FOR
 BUD HOOVER

RECEIVED
 JACKSON
 MAR 11 1964
 COUNTY
 SURVEYOR

REGISTERED
 OREGON
 LAND SURVEYOR
Edward A. McGinty
 EDWARD A. MCGINTY
 301

BY EDWARD MCGINTY
 MEDFORD OREGON
 FEB 1964

SCALE 1" = 200'
 ● = 5/8" I BOLT FD
 ○ = 1/2" I. PIN FD
 □ = 5/8" I. PIN

Survey No. 2448

Survey Narrative to comply with O.R.S. 209-250:

Survey for: Bud Hoover



Survey by: Edward A. McGinty, L.S.
2/20/64

BASIS OF BEARING: Agate Sub-div. Ext. No. 1:


PRECEDENCE OF SURVEY:

All monuments set on this survey are 5/8 in. iron pins 24 ins. long within 2 inches of the surface, with the exception of the witness corner set being approx. 4 ins. above the ground.

Monuments were found on adjacent surveys and Sub-divisions as shown.

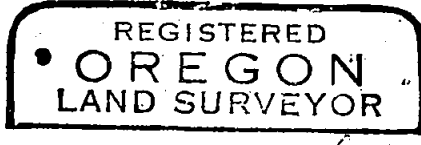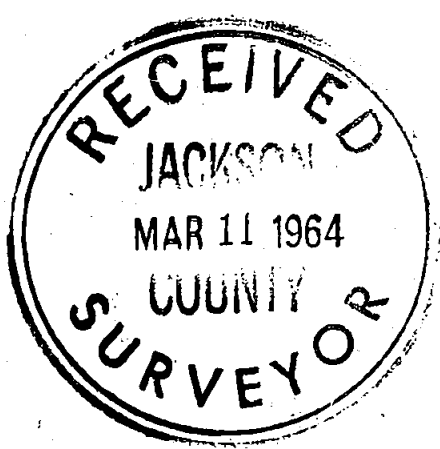

Edward A. McGinty

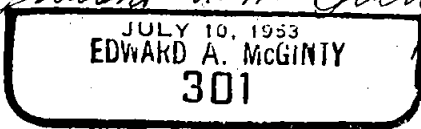

(Merry Lane)