

SUNSET PARK

Rec. 548 - 5' Deeded for street = 54.3

LOT 3 O'HARBAUGHS SUBD

Rec N66.25

set 1"x38" pipe

N0°05'55"E

d/p 66.92

set 5/8"x28" bar W

S89°56'05"E

p/p = 325.22

Rec East
Rec 332-5 to St = 327.0

set 1"x30" pipe

set 3/4"x30" pipe

Rec W. N89°56'05"W

set 3/4"x28" bar

set 3/4"x28" bar

68.0

130.00

130.00

Rec 135

136.36

NE Cor L3 by proportion

set 5/8"x30" bolt

68

68.36

LOZIER LANE

Frontage Record 1609.00 by survey 1270 = 1625.19

N89°56'05"W 545.01 Rec 546.0

LOT 6 O'HARBAUGH'S SUBD
SURVEY 1270

Rec 405.50

S0°05'55"W 409.59

f 5/8" bol

20 406.55 Rec 402.5

18.72

5/8" bar ref.

set 1"x30" pipe

set 5/8"x30" bar

1 1/2" pipe NE cor. D.L.C 77

SURVEY FOR ALYCE FITSIMMONS 306 LOZIER LANE MEDFORD, OREGON.
March 23, 1964 Bearings from survey no 1270
IN O'HARBAUGH'S SUBD. and D.L.C 76, T.37S. R.2 W. JACKSON COUNTY, OREGON.
Scale 1"=100'



REGISTERED
OREGON
LAND SURVEYOR
L. N. Dow
MAY 6, 1949
L. N. DOW
251

RECEIVED
JACKSON
APR 27 1964
COUNTY
SURVEYOR

Written narrative to accompany plat for Survey No. _____

2491

Survey for Alyce Fitsimmons, 306 Lozier Lane, Medford, Oregon.


In O'Harbaughs Subdivision, DLC 76, T 37S. R. 2 W Jackson County, Oregon.

March 23, 1964 Scale 1" = 100' Bearings from survey No. 1270.

Procedure: found the 1 1/2" pipe for the Northeast corner of D.L.C. NO. 77, found 5/8" bar on D.L.C. line near east line of Lozier Lane set by this surveyor long past for reference. the center of Lozier Lane on the D.L.C. Line missing and was reset from these last two points. Found 5/8" bolt at northeast corner of Lot 6 as shown on survey No. 1270.

We then chained out frontage to check prorate as shown on Survey No. 1270 and found it to be good.

With the above controls we then set pipes and bars for lot corners as shown on the attached plat.

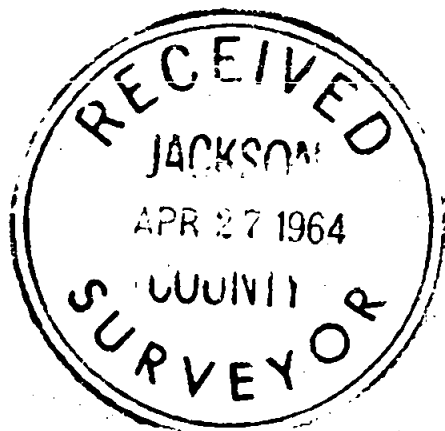

L. N. Dow

