

RECEIVED
JACKSON
 MAY 19 1964
COUNTY
SURVEYOR

REGISTERED
OREGON
 LAND SURVEYOR

J. A. Hoffbuhr
 NOVEMBER 7 1967
J. A. HOFFBUHR
 222

SE 1/4 SEC. 18,
 T. 36 S., R. 1 W., W.M.

FOUND LEAD PLUG
 WITH TACK
 18 17
 19 20
 SEC. COR. T. 36 S., R. 1 W., W.M.

BOUNDARY SURVEY OF PROPERTY
SITUATE IN
 S. E. 1/4 SEC. 18, T. 36 S., R. 1 W., W.M.
JACKSON COUNTY OREGON
FOR
WHITE CITY REALTY CO.
 (FOREST INDUSTRIES)

J. A. HOFFBUHR REG. L.S. MEDFORD, OREGON
 SCALE 1"=100' APRIL 9, 1964
 BEARINGS PER SURVEY NO. 2289
 ○ = SET 5/8" IRON PINS
 X = FOUND 3/4" IRON PINS
 ⊙ = BRONZ DISC MONUMENTS

Survey No. 2502

SURVEY NARRATIVE TO COMPLY WITH O.R.S. 209.250

FOR: White City Realty Co.
Post Office Box 526
White City, Oregon.

LOCATION: Section 18, Township 36 South, Range 1 West,
Willamette Meridian, White City, Oregon.



PURPOSE: To monument and describe a tract within the
White City Realty, Co. property in White City,
Oregon, proposed to be conveyed to Forrest
Industries Inc.

PROCEDURE:

Found street monuments previously set by the Army
Engineers for street centerline control.

Government corner tie was made as indicated on the
attached map.

Monumented the parcel as indicated on the map. Meridian
established from previously recorded survey No. 2289.

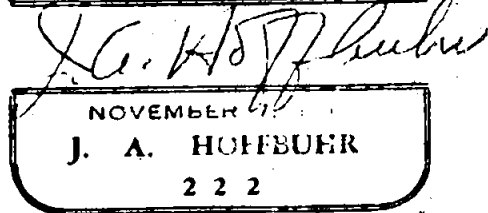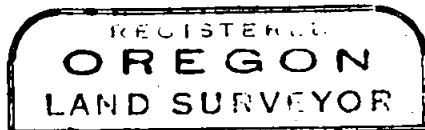

J. A. Hoffbuhr
Registered Land Surveyor

Work Completed April 64

