


FAYDREX, INC.
SECS 28-33

T.34 S. R.4 W. W.M
SCALE 300' = 1"

Mar. 1961

2643.3
5293.7

Note: See separate map for description of corners.
O 1/4" I.P. at each corner.

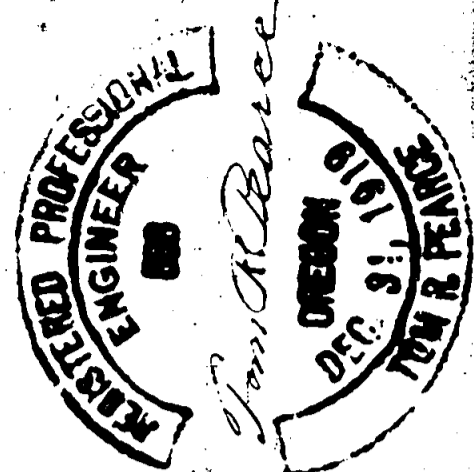

June 1, 1964

O.R.S. 209.250. Survey reestablishing lot corners in a previous
platted subdivision.

Survey numbers:.....**2524**.....

This narrative is to accompany the narrative dated January 10th,
1961 and map dated December, 1960, for the Faydrex, Inc, I. O.
Box 1545, Medford, Oregon.

The purpose is to explain the reason for filing another map,
dated March 1961, showing land in the Southwest quarter of the
Northeast quarter and the West half of the Southeast quarter
of Section 28 and the Northwest quarter of the Northeast quarter
of Section 33, all in Township 34 South, Range 4 West of the
Willamette Meridian, in Jackson County, Oregon.

Reason: The map dated December 1960, shows a road 30 feet in
width, lying along the entire West boundary of the property.
At that time, it was considered that the adjoining land owners
would also provide a 30 foot strip of land, in order to create
a 60 foot road, to be dedicated to Jackson County. Upon further
study, it appeared that the adjoining land owners may not be
willing to provide an area for road purposes. Therefore the
Faydrex, Inc., requested that their 30 foot strip of land be
eliminated from the map. This was approved.

Procedures: The iron pipes, set at corners 1 to 9 and 11 to 17,
inclusive, were moved West, on line, 30 feet. The corrected
acreage was computed and new descriptions provided.

Tom R. Pearce

Tom R. Pearce, R. E. No. 838

