



Survey No. 2527


Survey Narrative to Comply With Paragraph 209.250  
Oregon Revised Statutes

SURVEY FOR: Kenneth F. Dixon  
824 King Street  
Medford, Oregon.

PURPOSE OF SURVEY: To monument and describe the boundaries of the  
parcel of Land as indicated on the attached map.

SURVEY LOCATION: Tract of Land located in Southeast 1/4, Section 1,  
Township 38 South, Range 2 West, Willamette Meridian, Jackson County, Oregon.

SURVEY PROCEDURE: Located the Southeast Corner of Donation Land Claim No. 38  
Township 38 South, Range 2 West, Willamette Meridian, Jackson County, Oregon.  
also monuments as shown and described in Recorded Survey No. 1444. Basis of  
bearings; Previous surveys in this vicinity and shown in Recorded Survey  
No. 1444.

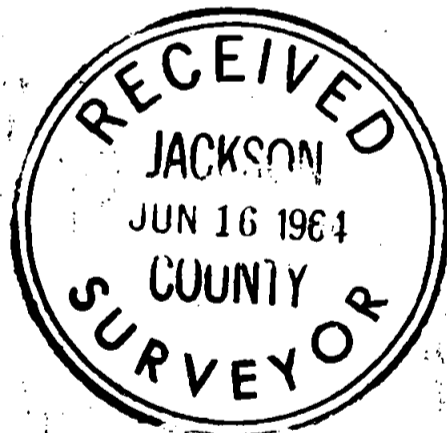

June 1964

J.A. Hoffbuhr  
Registered Land Surveyor

