

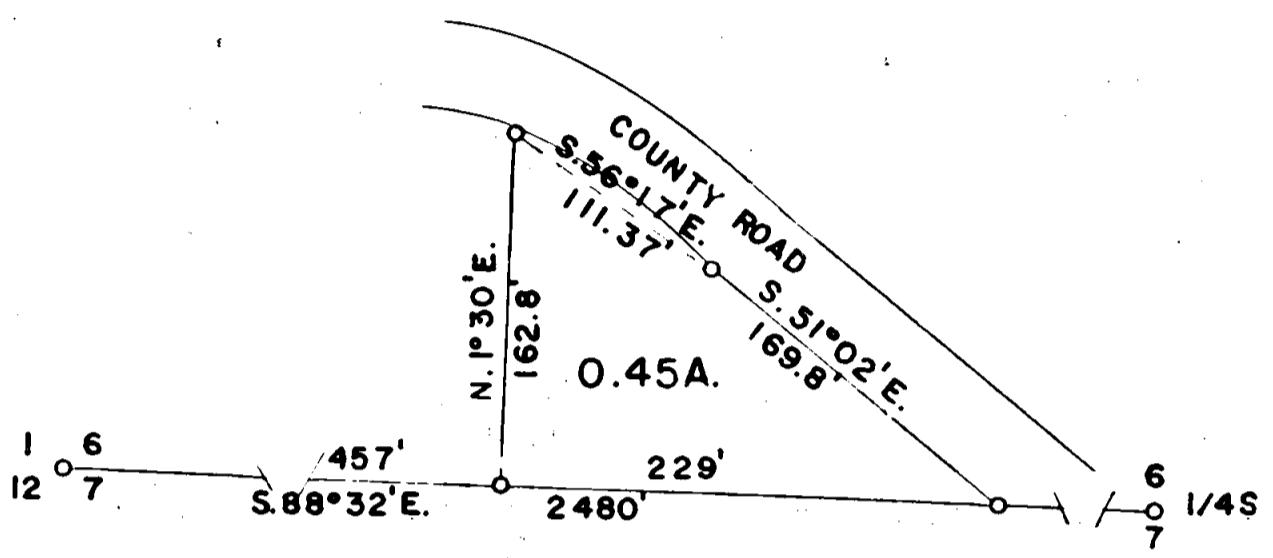


CCC 2  
535

T. 35S., R. 3W., W.M., JACKSON COUNTY  
OREGON  
METES AND BOUNDS SURVEY IN SECTION 6  
AT THE REQUEST OF W.D. MOON

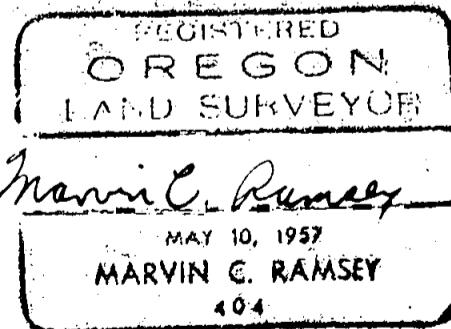

Scale: 1 inch = 100 feet

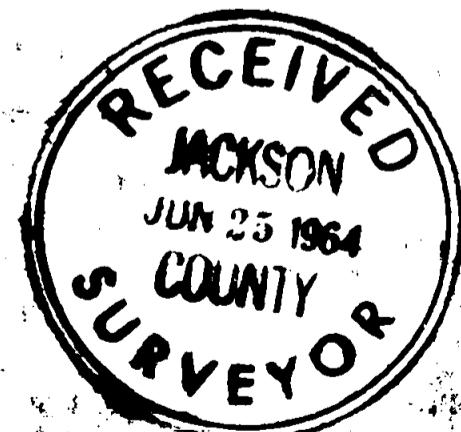

CCC 2  
535

T. 35 S., R. 3 W.

I determine the corner point of sections 1, 6, 7 and 12  
from the only extant original bearing tree

A white oak 26 ins. in diam., bears N.  $21^{\circ}$  W., 443 links  
distance, chopped with partial scribe mks. exposed.

A fence corner bears South 10 feet distance

Set an iron pipe 3 ft. long 2 ins. in diam., 28 ins. in  
the ground mkd. RS404, from which new bearing trees.

Ash 12 ins. in diam., bears N.  $41^{\circ}$  E., 90.4 ft. dist.,  
mkd. T35S R3W S6 RS404 BT

White oak 20 ins. in diam., bears S.  $7^{\circ}$  E., 313.5 ft.  
dist., mkd. T35S R3W S7 RS404 BT

Cedar 10' ins. in diam., bears S.  $5\frac{1}{2}^{\circ}$  W., 255.8 ft.  
dist., mkd. T35S R4W S12 RS404 BT

The geographic position of this corner is latitude  
 $42^{\circ} 32' 57''$  N., and longitude  $123^{\circ} 6' 56''$  W.

June 4, 1964 at this sec. cor. at 10:30 A. M., P.S.T., I  
set off  $42^{\circ} 33'$  N. on the lat. arc;  $22^{\circ} 30\frac{1}{2}'$  N., on  
the decl. arc; of my Gurley solar transit and  
determine a meridian with the solar attachment.  
Foresight and backsight method was used throughout  
this survey.

Thence

S.  $88^{\circ} 32'$  E., on true line bet. secs. 6 and 7.

457 Set an iron bolt 3 ft. long  $1\frac{1}{2}$  ins. in diam., 28 ins. in  
the ground.

686 To the County road and set an iron pipe 3 ft. long 1 in.  
in diam., 28 ins. in the ground, mkd. RS404

2480 To the  $\frac{1}{4}$  sec. cor. determined from the bearing trees  
by A. T. Brown in 1915.

A Douglas fir 36 ins. in diam., bears S.  $14\frac{1}{2}^{\circ}$  W., 88.1 ft.  
dist., I open to find scribe marks

A black oak 20 ins. in diam., bears N.  $26\frac{1}{2}^{\circ}$  E., 111.4 ft.  
dist., down and decayed.

New bearing tree

A Douglas fir 8 ins. in diam., bears N.  $12^{\circ}$  W., 17.7 ft.  
dist., mkd.  $\frac{1}{4}$  S6 RS404 BT

Return to the iron bolt on the sec. line from which the sec.  
cor. of secs. 1, 6, 7 and 12 bears N.  $88^{\circ} 32'$  W., 457 ft.  
dist., thence N.  $1^{\circ} 30'$  E., 162.8 ft. to the County road  
and set an iron pipe 3 ft. long 1 in. in diam., 28 ins. in  
the ground; thence along a curve to the right of which  
the subchord bears S.  $56^{\circ} 17'$  E., 111.37 ft.; thence  
S.  $51^{\circ} 02'$  E., 169.8 ft. along the County road to the  
sec. line; thence N.  $88^{\circ} 32'$  W., on the sec. line, 229 ft.  
to the point of beginning. Containing .45 acre.

REGISTERED  
OREGON  
LAND SURVEYOR

*Marvin C. Ramsey*

MAY 10, 1957  
MARVIN C. RAMSEY  
404

2535

TOWNSHIP 35 SOUTH, RANGE 3 WEST, WILLAMETTE MERIDIAN

JACKSON COUNTY, OREGON

METES AND BOUNDS SURVEY IN SECTION 6

EXECUTED AT THE REQUEST OF W. D. MOON

OF

R. F. D. 1 ROGUE RIVER, OREGON

BY

Marvin C. Ramsey, Registered Professional Land Surveyor

Assistant

Paul E. Jonas

Survey commenced June 4, 1964

Survey completed June 5, 1964

