




SCALE 1"=200'

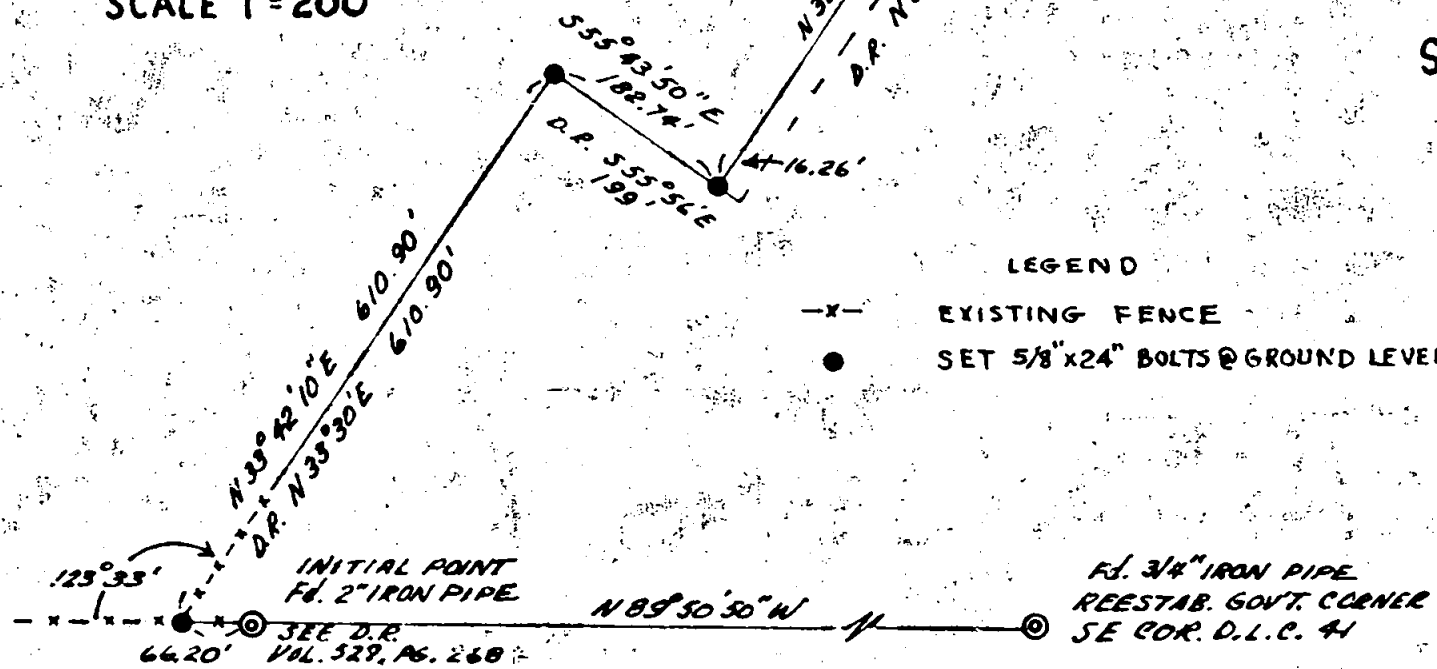


SET PIN ON APPROX. SO. BDY. OF R/W

LEGEND

- x- EXISTING FENCE
- SET 5/8"x24" BOLTS @ GROUND LEVEL


Fd. 3/4" IRON PIPE REESTAB. GOVT. CORNER SE COR. D.L.C. 41

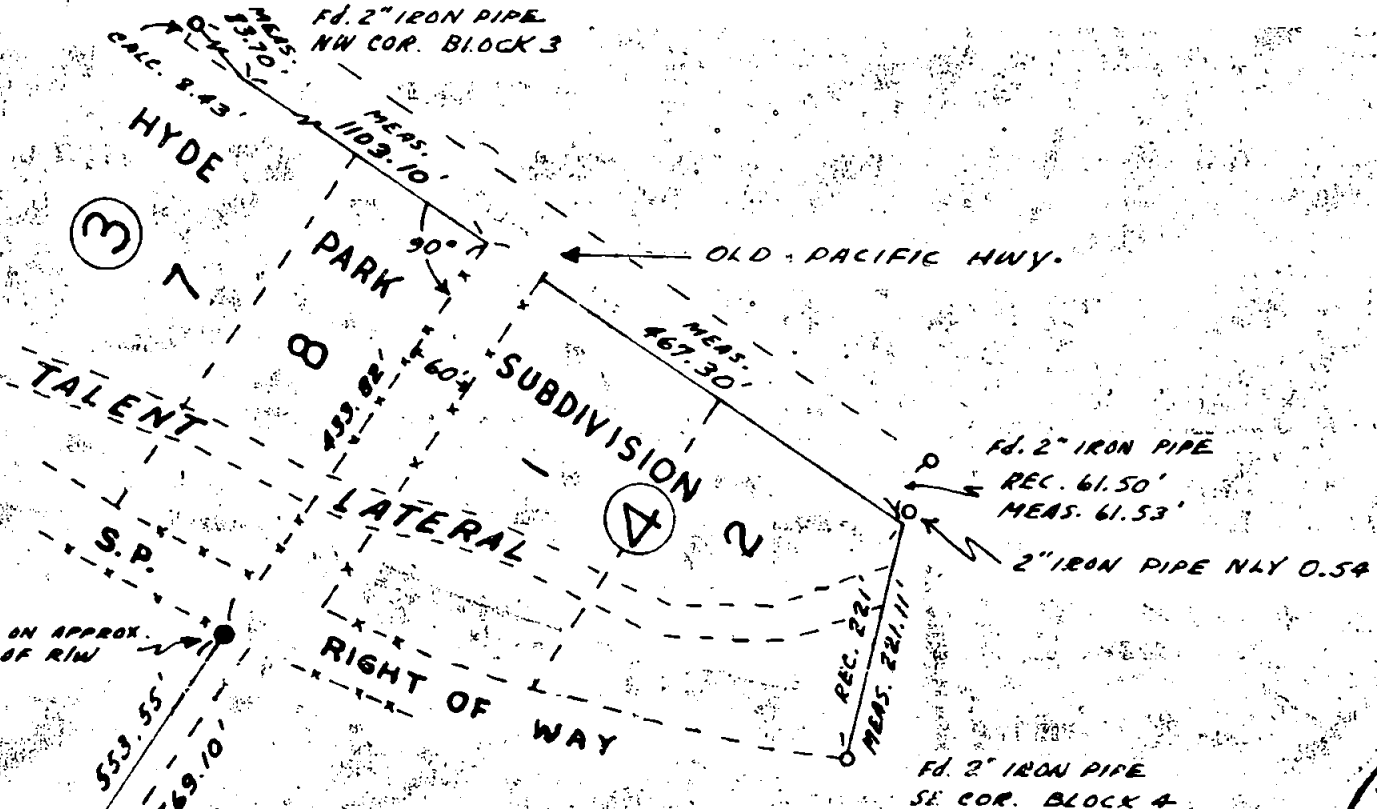


SURVEY IN PORTIONS OF

NE 1/4 NW 1/4 SECTION 36
D.L.C. 72
T. 38 S., R. 1 W., W.M.

for
EDWARD G. MEILICKE
BY
CHARLES H. HURST
MEDFORD, OREGON
APRIL 13, 1964

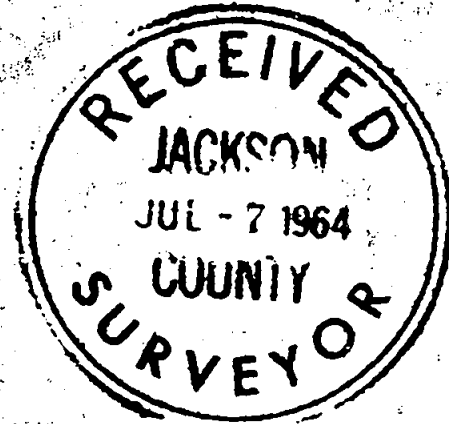

Charles H. Hurst

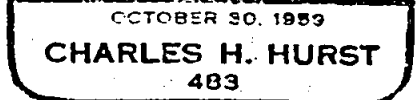

SURVEY NARRATIVE TO COMPLY WITH PARAGRAPH 209.250

Oregon Revised Statutes

Survey for: Edward G. Meilicke
Route 1, Box 115
Old Pacific Highway
Talent, Oregon

Survey by : Charles H. Hurst
765 Sunrise Avenue
Medford, Oregon

Equipment : Six second optical transit and 300 foot tape

Purpose : To locate the east boundary of that tract of land described in D. R. vol. 527, page 268 for the purpose of fence construction



Procedure : Commenced retracement per deed at the two inch pipe called for as the SW corner of DLG 72 and closed on monuments of the Hyde Park Subdivision as shown on the attached plat.

Conflicts : Subject deed does not close mathematically by 41.33 feet in latitude and 37.62 feet in departure. The west boundary of adjacent property to the east is anchored to the east side of D. R. 527, page 268. Deed research did not make basic intent apparent although old time residents in the area claim said boundary should coincide with the west side of street extending South. Field measurements show a discrepancy of 16.26 feet with this boundary.

Tract E of D. R. 595-330 appears to support the claims of old time residents. Accordingly, monuments were set on the west boundary of the road as extended and deed record discrepancies are shown in contrast with measured distances and bearings.

In this instance, the establishment of an agreement line appears desirable.

Date: April 14, 1964

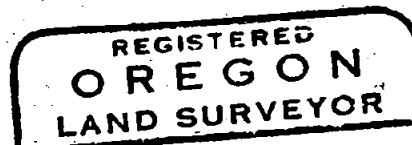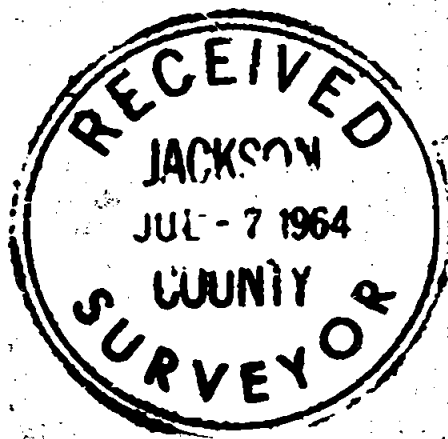

Charles H. Hurst

OCTOBER 30, 1959
CHARLES H. HURST
483