


2557

Survey For:
MARVIN KESNER
Located in the SW 1/4
of the SE 1/4 of Sec. 32,
T36SRIW, W.M.
By: Mark E. Boyden
Work Commenced April 20, 1964
Work Completed July 29, 1964

REGISTERED
OREGON
LAND SURVEYOR
Mark E. Boyden
NOVEMBER 1951
MARK E. BOYDEN
281

RECEIVED
JACKSON
AUG - 3 1964
CLATSOP
COUNTY
SURVEYOR

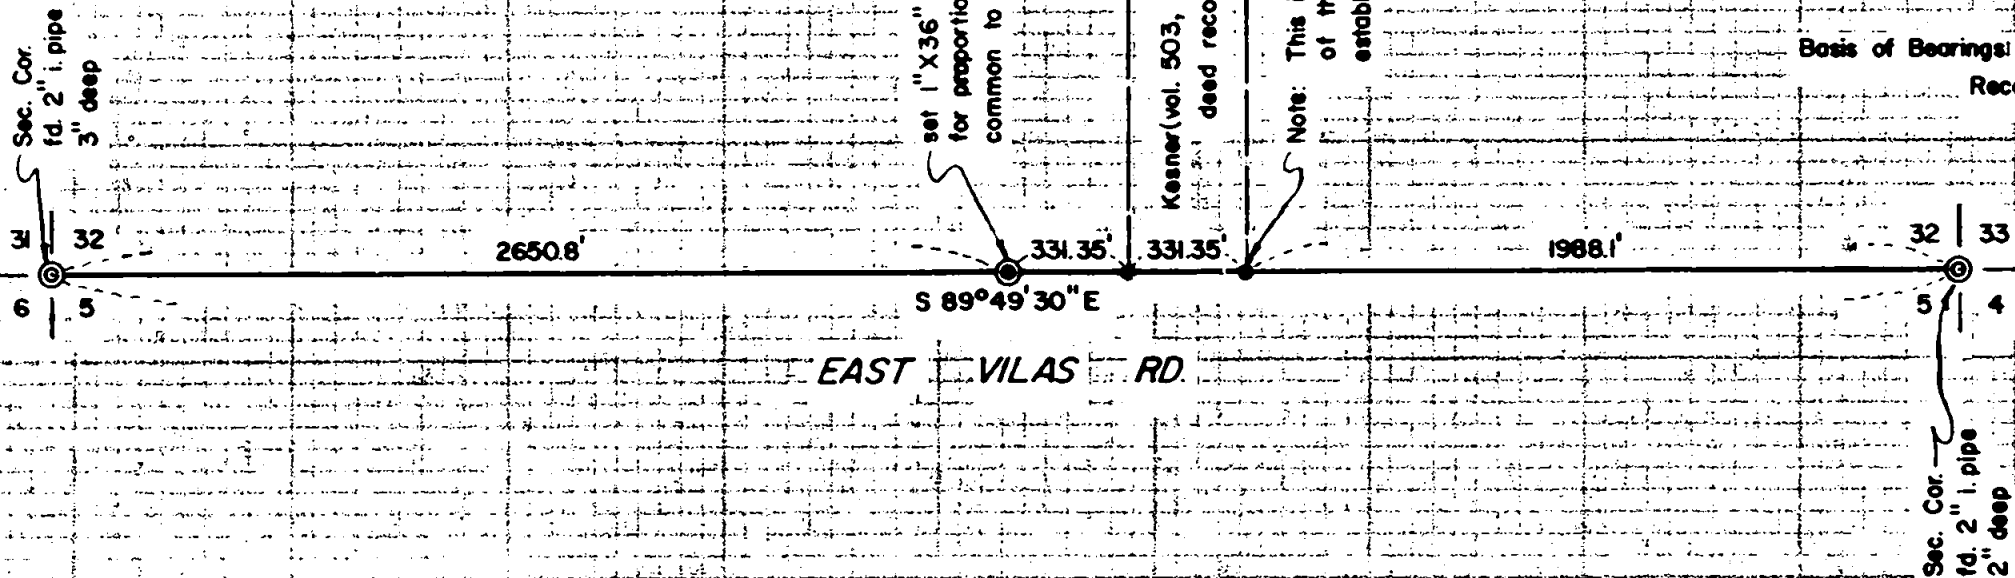

2557

SURVEY NARRATIVE TO COMPLY WITH O.R.S. 209.250
REVISED BY CHAPTER 555, O.L. 1963

FOR: Marvin Kesner
East Vias Road
Medford, Oregon

PURPOSE: To monument the Southwest and Southeast corners of the tract described in Volume 503, Page 22 of the Deed Records of Jackson County, Oregon.

PROCEDURE:

Found the Southeast and Southwest corner monuments of Section 32, Township 36 South, Range 1 West, as set and renewed by the Deputy County Surveyor on June 2, 1955 and April 26, 1956 respectively.

Chained between said corners, setting a 1" galvanized iron pipe with bronze cap for the proportionate quarter section corner.

Also proportioned the position of the said property corners as shown.

It should be noted, that on Recorded Survey No. 334, the corner pipe set for the Southeast corner of Section 32 by County Surveyor A.T. Brown on January 20, 1914 was not located, and a theoretical corner position approximately 27 feet West of the true corner was utilized on said survey.

The Southerly corner monuments set on said survey could not be located, but by computations of surveys in this area, it appears that said survey encroached upon the presently described Kesner property by approximately 22 feet.

July 29, 1964

