


SURVEY IN D.L.C. 49
NE 1/4 NE 1/4 SECTION 8
T. 37 S., R. 2 W., W.M.
FOR
TOM R. WILLIAMS

BY CHARLES H. HURST, L.S.
MEDFORD OREGON
JULY 24, 1964

LEGEND
● SET 1/2" X 24" IRON PIPE
WITHIN 2" OF GROUND
○ 1" PIPE PER SURVEY 462
ITALICS - RECORD DATA

SCALE 1" = 50'

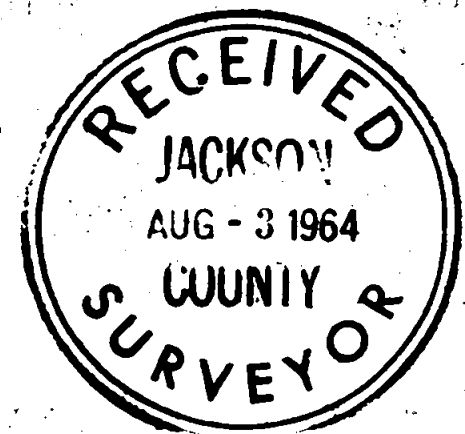

REGISTERED
OREGON
LAND SURVEYOR

Charles H. Hurst

OCTOBER 30, 1959
CHARLES H. HURST
483

2558

Survey No. 2559
Amended

SURVEY NARRATIVE TO COMPLY WITH PARAGRAPH 209.250

OREGON REVISED STATUTES

Survey for: Tom R. Williams
Rte. 1, Box 269 A
Central Point, Oregon

Survey by: Charles H. Hurst, L.S.
765 Sunrise Avenue
Medford, Oregon

Brg. basis: Recorded survey 462

Purpose: To separate the smaller tract from a previously surveyed parcel.

Procedure: Commenced at the southeast corner of the previously surveyed parcel and ran courses and distances as shown per client's request.

This survey is based on control already established for the east boundary of the larger parcel.

Since the survey made June 22, 1964 (# 2559), the client, in conjunction with a neighbor, revised the west boundary as shown. Accordingly, survey 2559 is amended as shown on the attached plat.

Date completed: July 24, 1964

