

REGISTERED
OREGON
LAND SURVEYOR

J.A. Hoffbuhr

NOVEMBER 7, 1964
J. A. HOFFBUHR
2 2 2

BOUNDARY SURVEY OF PROPERTY

situate in
S.W. 1/4 of N.E. 1/4 of S.W. 1/4 Sec. 27., T.32S, R.3E, W.M.
Jackson County Oregon
For
Fred Schaffran and Donald W. Andresen
J.A. Hoffbuhr L.S. Medford, Oregon
Scale: 1" = 60' June 29, 1964
Bearings based on 1929 survey by C.Z. Boyden
o = set 5/8" x 24" iron reinforcing pin

SURVEY NO. 2561

Survey Narrative to Comply With Paragraph 209.250
Oregon Revised Statutes.

SURVEY FOR: Fred Schaffran
and
Donald Andresen
Prospect, Oregon.



PURPOSE OF SURVEY: To monument the corners of the two tracts as indicated on the attached map.

SURVEY LOCATION: Tracts located in the Southwest 1/4 of the Northeast 1/4 of Southwest 1/4, Section 27 Township 32 South, Range 3 East, Willamette Meridian in Jackson County, Oregon.

SURVEY PROCEDURE: The records of a survey made by C.Z. Boyden in 1929 were used to locate the 1/16 corners which were established by a subdivision of Section 27. The corners found and used for this survey and the distances and bearings indicating their location are as shown by the attached map.

July 1964

J.A. Hoffbuhr
Registered Land Surveyor

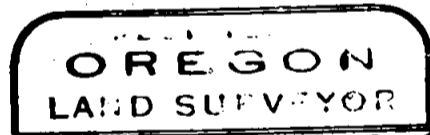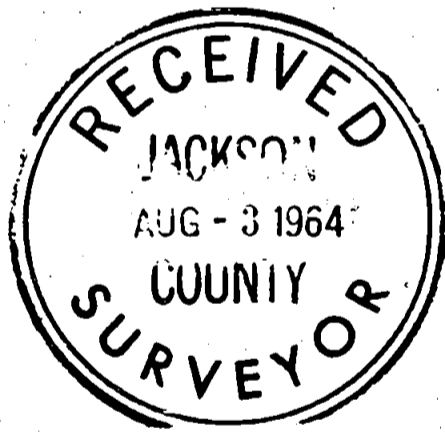

J.A. Hoffbuhr
NOVEMBER 1 1964
J. A. HOFFBUHR
222