


Note: Orient bearings this survey to left 0°03'10" to correlate bearings of Recorded Surveys No's 981, 982, 1967, 2153 and 2498.

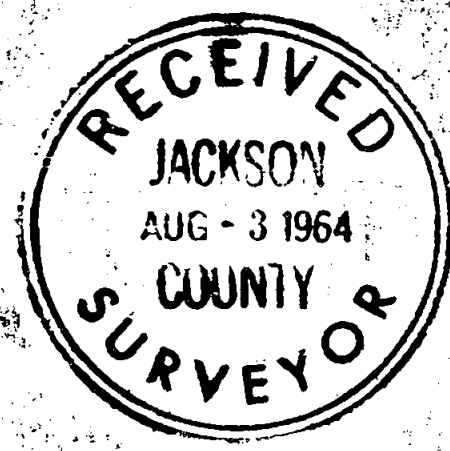

REGISTERED
OREGON
LAND SURVEYOR

J. A. Hoffbuhr

NOVEMBER 4, 1964
J. A. HOFFBUHR
222

BOUNDARY SURVEY OF PROPERTY
SITDATE IN
D.L.C. No. 39 AND S.W. 1/4 SECTION 18,
T.37S., R.1W., W.M., JACKSON CO., ORE.
FOR
MAC-DISCO-MART-INC.
J.A. HOFFBUHR L.S. MEDFORD, ORE.
SCALE: 1"=100' JUNE 4, 1964
BEARINGS BY SOLAR OBSERVATION
o = SET 5/8" IRON REINFORCING PIN

Sur. # 25 Sun's d @ 0 hr 5-23-1964 (K&E Ephemeris) = N 20° 32.6' change per hour = + 0.48'

Clear
 Pac. D/L Time
 correction made
 for Std. Time
 70° F
 Elev. 1320
 Lat. 42° 20' 50"

$$\cos Z = \frac{\sin d - \sin h \times \sin l}{\cos h \times \cos l}$$

#3

G.C.T. = 17:15.0
 Sun's d @ 0 hr. = 20° 32.6'
 Chg. = + 0° 08.3'
 Sun's d'' = 20° 40' 55"
 Mers. Alt. = 47° 52.8'
 -(0.87)(0.97)(0.96) + 0.10 = - 0° 00.8'
 True Alt. = 47° 52' 00"

$$\cos Z = \frac{.3531800 - (.7415857)(.6736219)}{(.6708582)(.7390762)}$$

$$= \frac{.3531800 - .4995484}{.4958153}$$

cos Z = -.2952075 = 572° 49' 50" E
 Lt. = 17° 06' 40"
 s/l D.L.C. No. 39 S 89° 56' 30" E

#4

G.C.T. = 17:18.6
 Sun's d @ 0 hr. = 20° 32.6'
 Chg. = + 0° 08.3'
 Sun's d'' = 20° 40' 55"
 Mers. Alt. = 48° 29.5'
 -(0.87)(0.97)(0.96) + 0.10 = - 0° 00.7'
 True Alt. = 48° 28' 50"

$$\cos Z = \frac{'' - (.7487308) ''}{(.6628742) ''}$$

$$= \frac{'' - .5043615}{.4899145}$$

cos Z = -.3085875 = 572° 01' 30" E
 Lt. = 17° 55' 20"
 s/l D.L.C. No. 39 S 89° 56' 50" E

#5

G.C.T. = 17:21.8
 Sun's d @ 0 hr. = 20° 32.6'
 Chg. = - 0° 08.3'
 Sun's d'' = 20° 40' 55"
 Mers. Alt. = 49° 02.0'
 -(0.83)(0.97)(0.96) + 0.09 = - 0° 00.7'
 True Alt. = 49° 01' 20"

$$\cos Z = \frac{'' - (.7549640) ''}{(.6557663) ''}$$

$$= \frac{'' - .5085603}{.4846613}$$

cos Z = -.3205956 = 571° 18' 00" E
 Lt. = 18° 39' 20"
 s/l D.L.C. No. 39 S 89° 57' 20" E

Brg. on s/l D.L.C. No. 39 = S 89° 56' 50" E LISE

REGISTERED
OREGON
 LAND SURVEYOR

J. A. Hoffbuhr

NOVEMBER
J. A. HOFFBUHR
 222

Survey Narrative to Comply With Paragraph 209.250,
Oregon Revised Statutes

SURVEY FOR: Ray Winther Company.
925 Linden Avenue
South San Francisco,
California.

PURPOSE OF SURVEY: To monument and describe the parcel of land as indicated
on the attached map.

SURVEY LOCATION: Tract situated in Donation Land Claim No. 39 and Southwest
1/4 of Section 18, Township 37 South, Range 1 West, Willamette Meridian, in
Jackson County, Oregon.


SURVEY PROCEDURE: Bearings were determined from solar observations, the
computations are attached and made a part of this narrative. The correlation
of the bearings with other recorded surveys are indicated on the attached map.
The Donation Land Claim Line between the Southeast Corner of Donation Land Claim
No. 39, Township 37 South, Range 1 West, and the Northwest Corner of Donation
Land Claim No. 61 Township 37, South, Range 2 West was traversed and the South
Line of the tract positioned as a common line with said Donation Land Claim
Line.

The Oregon State Highway Department Construction plans were used to position
the Westerly line at the Easterly right-of-way line of the relocated Biddle Road,
the iron pins set by the Oregon State Highway Department were found to be in
error as indicated on the map.

The Easterly and Northerly lines were positioned according to the record
distances and the 1 inch iron pipe at the Southeast Corner and the 5/8 inch iron
pin at the North East corner were found also to be in error in the amounts shown
on the map.

July 1964

J.A.Hoffbuhr
Registered Land Surveyor.

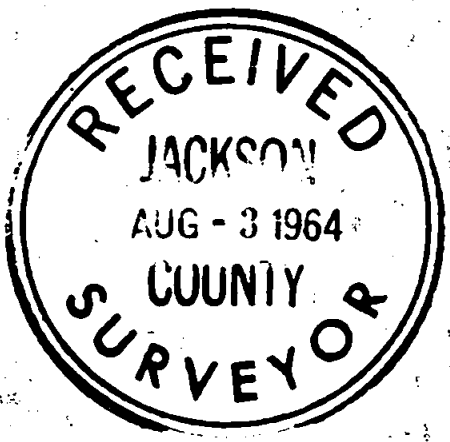

J.A. Hoffbuhr
NOVEMBER
J. A. HOFFBUHR
2 2 2