

2564

OREGON ST.

FD. 3/4" PIPE

CALIFORNIA ST.
N 67° 22' 20" W

30'

30'

26.67'

55.00'

26.67'

55.00'

FD. 3/4" S.Q. PIN

S 22° 38' 45" W

FD. 5/8" I. PIN

'C' ST.


'D' ST.

30'

30'

30'

30'

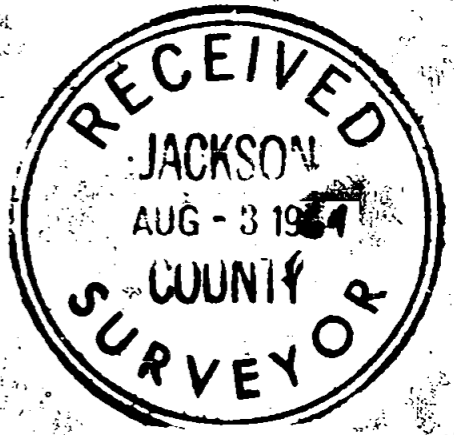

BEARINGS PER RECORDED SURVEY NO. 2581.

REGISTERED OREGON LAND SURVEYOR

J. A. Hoffbuh

NOVEMBER 7, 1964
J. A. HOFFBUHR
222

BOUNDARY SURVEY OF PROPERTY
SITUATE IN
LOT 4, BLOCK 4, ORIG. TOWN OF JACKSON-
VILLE ORE. NE. 1/4, SEC. 32, T.37S, R. 2W, W.M.
JACKSON COUNTY OREGON
FOR
PACIFIC NORTHWEST BELL
J.A. HOFFBUHR L.S. MEDFORD, OREGON
SCALE: 1" = 30' JULY 17, 1964

- = SET 5/8" REINF. PIN
- = SET LEAD PLUG WITH COPPER TACK

2564

SURVEY NO. 2564

Survey Narrative to Comply With Paragraph 209-250
Oregon Revised Statutes


SURVEY FOR: Pacific Northwest Bell Telephone Company.
412 Southwest Oak Street
Portland, Oregon.

ATT: R.C. Flaming
Building Engineer

PURPOSE OF SURVEY: To Monument the corners of the tract as indicated on
the map.

SURVEY LOCATION: Portion of Lot 4 Block 4, of the Town of Jacksonville,
Oregon. Being located in the Northeast 1/4 of the Northwest 1/4 of Section
32, Township 37 South, Range 2 West, Willamette Meridian in Jackson County,
Oregon.

SURVEY PROCEDURE: Control for the centerline of California street was
established from a 3/4 inch square iron pin at the intersection of
California and Fifth Street and a 3/4 inch pipe at the intersection of
California and Oregon Streets, the control for Fifth Street was established
from 5/8 inch iron pins found at the intersections of Fifth Street with C
and D Streets as indicated on the attached map.

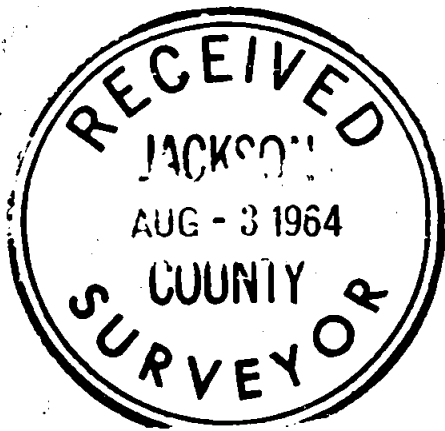

July 1964.

J.A. Hoffbuhr,
Registered Land Surveyor.

