

Survey No. 2577

Jackson County Surveyor  
Mark Boyden  
Medford, Oregon  
July, 1964


Corner reference to a BLM corner monument, which is a standard BLM monument marked 1/4, between Section 7, T36S, R3E, and Section 12, T36S, R2E: (note, corner monument not officially approved as of this date by the BLM)

To perpetuate its location -


Found a white fir, 8 ins. dia., bears S.  $62\frac{1}{2}^{\circ}$  W., 59.6 ft., scribed 1/4 S 12 BT.

New tree

A ruple, 14 ins. dia., bears N.  $51\frac{1}{2}^{\circ}$  E., 28.1 ft., mrk. 301 BT.

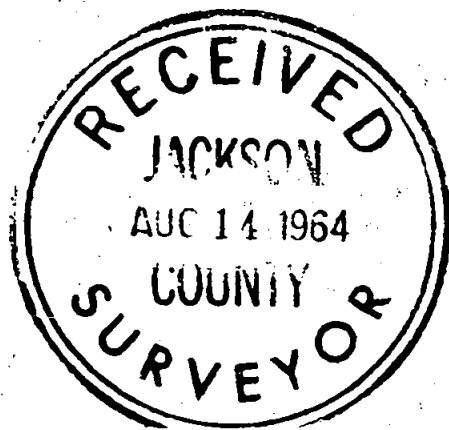

*Edward A. McGinty*

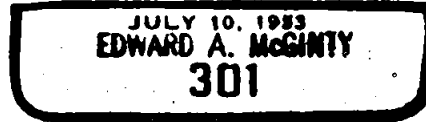

HM