

MAP OF SURVEY  
FOR

VICTOR STEWART, 1149 NEIL CREEK ROAD,  
ASHLAND, OREGON.

LOCATION: S.W. 1/4 & PORT. SE 1/4 OF } SEC. 30,  
                  OF SW 1/4                    SW 1/4 } T. 39S., R. 2E., W.M.

DATUM: REC. BEARING OF EAST LINE SHOWN  
ON MAP OF AUSLAND-DODSON SURVEY,  
OF 1946, MON. SHOWN AS FOUND WERE  
SET BY AUSLAND & DODSON, 1946

DATE: 8-14-64

SCALE: 1" = 100'

- = TRAVERSE HUBS
- = MON. FOUND AS DESCRIBED
- ✱ = 3/4" IRON PIPES SET



*L. E. Ager*  
MARCH 10, 1944  
L. E. AGER  
21

2593



Survey No. 2593

FOR: Victor Stewart,  
1149 Neil Creek Road, Ashland, Oregon.

LOCATION: South Half of Southwest Quarter of Section 30, T. 39 S.,  
Range 2 E., W.M.

PURPOSE; To monument the boundaries of and describe parcels of  
land shown on map.

PROCEDURE: The North and East boundaries of tract previously  
surveyed and monumented and shown on map prepared  
by Ausland- Dodson, their survey, 1946 for Cliff  
Wilson, survey of tracts on Neil Creek bordering on  
the East line of this map. They show the West  $\frac{1}{4}$  corner  
and the Southwest corner of the Section as found and  
the S.W.  $\frac{1}{16}$  corner being established on the line  
between these corners. I retraced the Ausland-Dodson  
boundary survey and found the monuments set by them  
which I used for control.

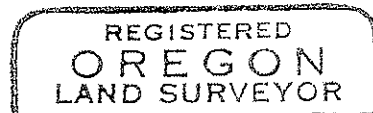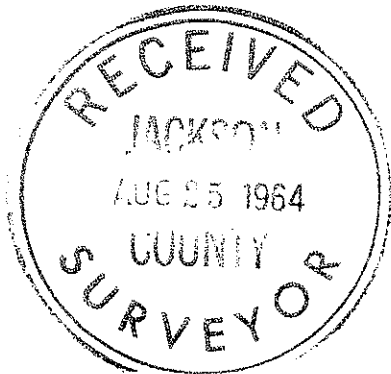

*L. E. Ager*

