

2603

100'

HIGHWAY

LAKE

CRATER

100'

(D.S.H. No. 62)

Lc. N 2° 15' 40" W 331.21'

R. 11509.16'

L. 331.22'

O.S.H. Sta. 1671+00.00 P.O.C.  
Found 3/8" iron pin

75.58'

60'

S 89° 47' 40" E

552.61'

COUNTY

ROAD

1257.31'

704.70'

N 1° 12' 40" W 331.08'

331.09'

S 0° 03' 20" E

546.55'

N 89° 47' 10" W

1244.56'

698.01'

2950.07'

1/4 Section corner  
T. 35 S., R. 1 W., W.M.  
found 1" G.I. pipe



REGISTERED  
OREGON  
LAND SURVEYOR

*J. A. Hoffbuhr*

NOVEMBER  
J. A. HOFFBUHR  
222

**SURVEY MAP OF PROPERTY**

situate in  
N.W. 1/4 Section 22, T. 35 S., R. 1 W., W.M.  
Jackson County Oregon

for  
Bertha R. Uhrich


J.A. Hoffbuhr L.S. Medford, Ore.

Scale: 1" = 100' August 19, 1964

Bearings per Recorded Survey No. 936

o = set 3/8" iron pin

1/4 Section corner  
T. 35 S., R. 1 W., W.M.  
found 3/8" iron pin

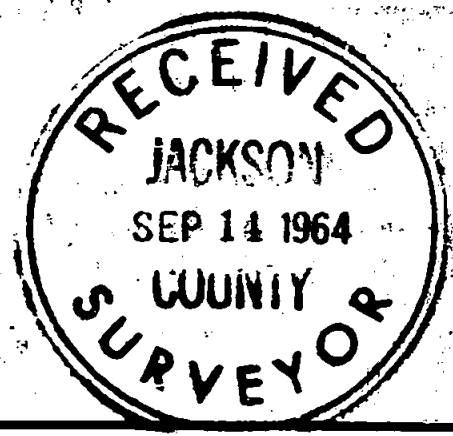


2603

Survey Narrative To Comply With Paragraph 209.250  
Oregon Revised Statutes

SURVEY FOR: Mrs. Bertha R. Urich  
1725 Oregon Avenue  
Medford, Oregon

PURPOSE OF SURVEY: To monument and describe the tract of land described as the North half of the South half of the South East Quarter of the North West Quarter of Section 22, Township 35 South, Range 1 West of the Willamette Meridian, Jackson County, Oregon.

SURVEY PROCEDURE: The survey control and bearings assembled by this office for Recorded Survey No. 936 was used for this survey. The above controls consist of a control traverse which was run on the perimeter of the entire Section, from which all the corners were found and coordinated except the East Quarter corner and the West Quarter corner, the location of these corners were determined by single proportioned positioning as required and the dimensions of the tract were computed and monuments as indicated on the attached map.

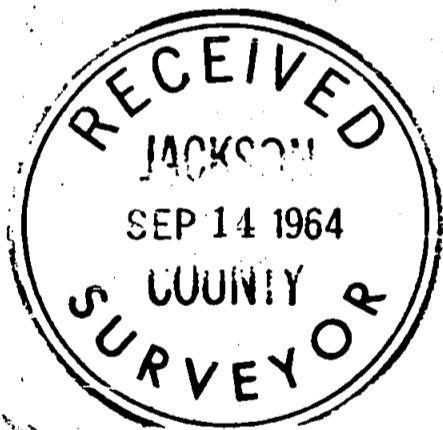

August, 1964

J. A. Hoffbuhr  
Registered Land Surveyor

