

2607

County Sta.  
PC. 163+94.0

Survey For  
MRS. ARA P. ARNOLD  
Located in the N.W. 1/4 of Sec. 3,  
T. 36 S., R. 4 W., W.M.  
By: Mark E. Boyden  
August 21, 1964

County Sta.  
PT. 157+14.8

witness cor.

ARNOLD  
VOL. 527, PGE. 297  
LESS VOL. 528, PGE. 386  
DEED RECORDS

County Sta.  
PC. 154+92.4

East 1695.4'

N 89°42'E 166.75'

S 9°44'20"E  
50.00'

N 85°13'40"E 247.81'

N 62°23'10"E 592.96'

COOL  
VOL. 528, PGE. 386  
# VOL. 559, PGE. 43  
DEED RECORDS

REGISTERED  
OREGON  
LAND SURVEYOR

*Mark E. Boyden*  
NOVEMBER 3, 1951  
MARK E. BOYDEN  
281

North 232.9'

E. EAST EVANS CREEK ROAD  
S 16°58'40"W

1/4 Sec. corner  
Fd. 1" iron pipe flush  
with ground surface

RECEIVED  
JACKSON  
SEP 24 1964  
COUNTY  
SURVEYOR

SCALE: 1" = 100'

- Fd. 5/8" iron pin
- Set 5/8" x 24" iron pin flush with ground surface

Meridian by Solar Observation

2607

2607

SOLAR OBSERVATION COMPUTATION:

LOCATION:

East Evans Creek Road, vicinity of "East-West" centerline of Section 3, Township 36 South, Range 4 West, Willamette Meridian.

TIME:

8:57 - 9:05 A.M. Pacific Daylight Time  
Friday, August 7, 1964

LATITUDE:

Scaled from quad sheet = 42° 28' 20"

DECLINATION:

+16° 17' 40"

NUMBER OF INDIVIDUAL OBSERVATIONS:



4

COMPUTED BEARINGS OF RANDOM TRAVERSE:

- (1) North 56° 33' 10" East
- (2) North 56° 33' 30" East
- (3) North 56° 32' 50" East
- (4) North 56° 33' 30" East

MEAN RANDOM BEARING:

North 56° 33' 10" East

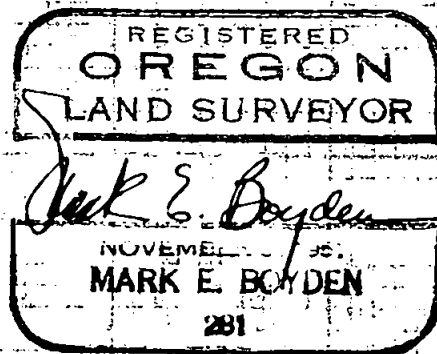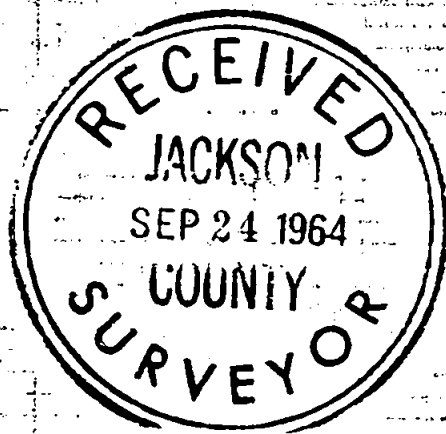

Survey No. 2607

SURVEY NARRATIVE TO COMPLY WITH O.R.S. 209.250  
REVISED BY CHAPTER 555, O.L. 1963

FOR: Mrs. Ara P. Arnold  
RR #1, Box 28-D  
Rogue River, Oregon

PURPOSE: To monument and describe an agreement boundary  
between the Arnold and Cool properties.

PROCEDURE:

Found road and government corner controls, monumenting  
the agreement boundary as shown.

September 14, 1964

