
NE 1/4 S. 27, T37 S. R I W. Jackson County, Oregon. Date August 24, 1964 Bearings from Survey No. 948

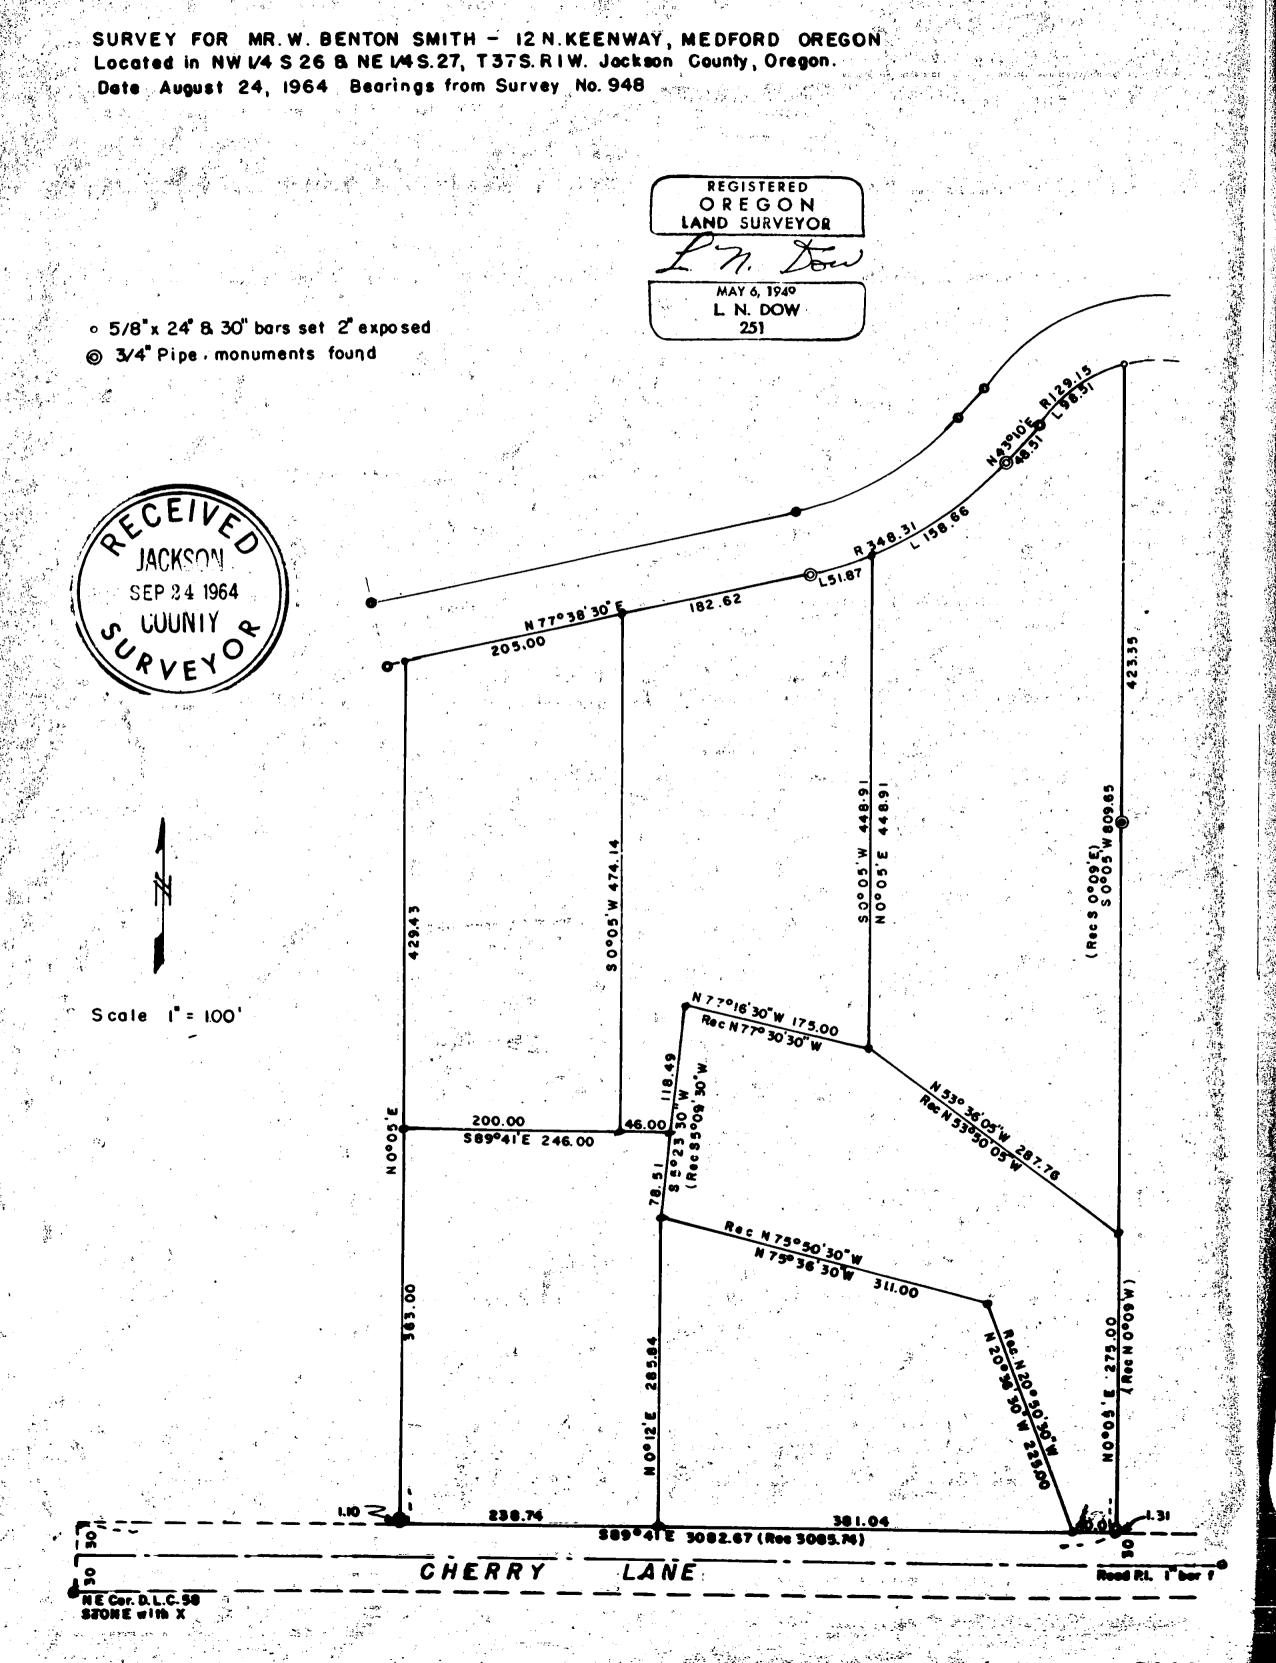

Written narrative to accompany plat for Survey NO.

Survey for Mr. W. Benton Smith, 12 North Keenway, Medford, Oregon.
Located in NW 1/4 Sec. 26 & NE 1/4 Sec. 27 T 275 D 3 11

Located in NW 1/4 Sec. 26, & NE 1/4 Sec 27, T.37S.R.1 W. (W.M.) Jackson County, Oregon.

Date August 24, 1964 Bearings from survey NO., 948

Proceedure:

Found stone with cross for the NE corner of D.L.C. NO. 58 on the south line of Cherry Lane, and found 1" bar for the road center at the P.l. point on the east end of the tangent for Cherry Lane. We then chain checked the entire tangent to determine accuracy of the original pipes found. We found that the original corners for the tract were not accurately set on the right of way line, we found the 3/4" pipes for the original southwest corner, the original southeast corner, the original northeast corner and the original northwest corner, also we found all curve point references along the new road along the north line of tract.

From the above we made a complete boundary layout using original and existing monuments, and set 5/8" bars at 2" exposure for corners as shown on the attached plat.

SEP 24 1964

SUUNIY Q

PVEY

OREGON LAND SURVEYOR

MAY 6, 1949
L. N. DOW
251

REGISTERED