


Survey For:
DAVID L. RICE
Located in the NE 1/4
Sec. 3, T37SRIW, W.M.
By: Mark E. Boyden
Sept. 15, 1964

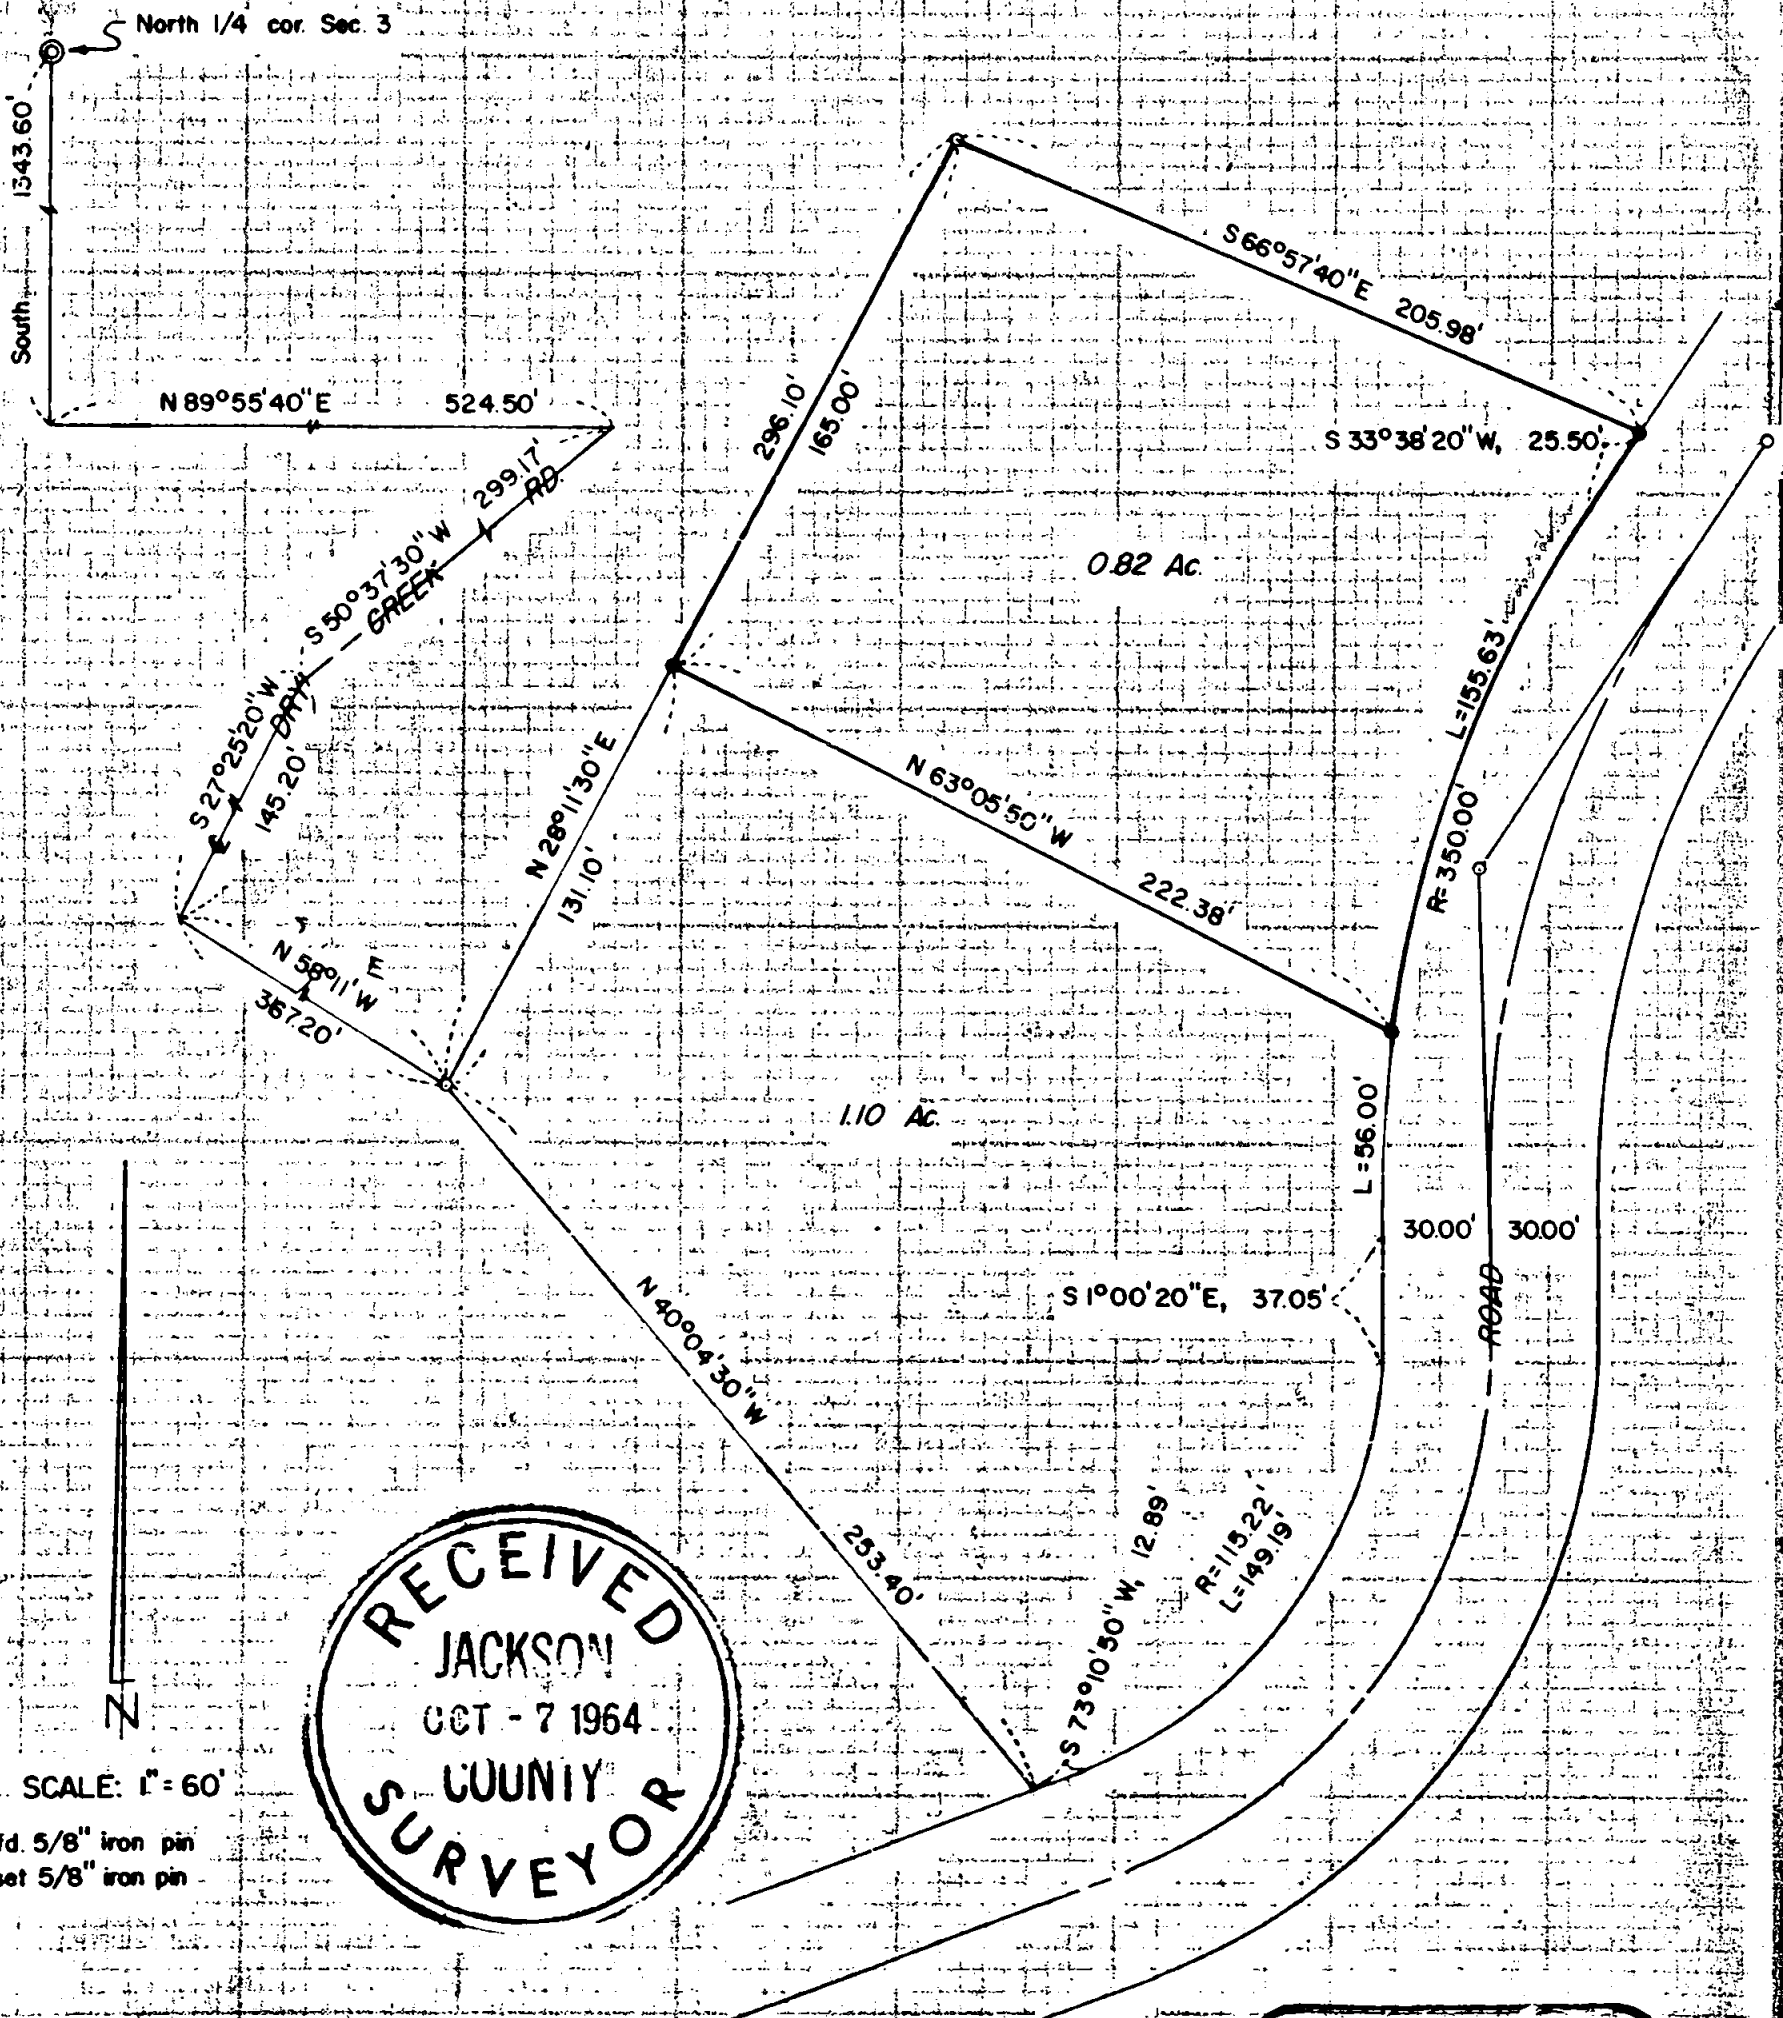

For outside bdy. control, see recorded survey no. 1383.

REGISTERED
OREGON
LAND SURVEYOR

Mark E. Boyden

NOVEMBER 9, 1964
MARK E. BOYDEN
281

Survey No. 2618

SURVEY NARRATIVE TO COMPLY WITH O.R.S. 209.250
REVISED BY CHAPTER 555, O.L. 1963

FOR: David L. Rice
3440 Lower River Road
Grants Pass, Oregon

PURPOSE: To monument a division line and prepare two legal descriptions for that 1.92 acre parcel previously monumented on Recorded Survey No. 1383.

PROCEDURE:

Found controlling monuments, setting pins for the division line as shown.

September 15, 1964

