

SURVEY NARRATIVE TO COMPLY WITH O.R.S. 209.250
REVISED BY CHAPTER 555, O.L. 1963


FOR - ELK LUMBER COMPANY
P. O. BOX 606, MEDFORD, OREGON

PURPOSE - To remonument and perpetuate the section corner common to Sections 5, 6, 7 and 8, Township 32 South, Range 2 East, Willamette Meridian.

PROCEDURE -

1. Identified the original Northeast and Northwest BT's and the down and badly decayed remains of the original Southeast and Southwest BT's. The original Northeast BT is now a 24 inch White Oak showing old faces but with scribe markings destroyed by decay. The original Northwest BT is now an 11 inch White Oak with both faces opened and scribing plainly visible in the upper face.
2. Set the corner point at the midpoint of locations determined by record bearing and distance from the original Northeast and Northwest BT's and the stump hole of the Southwest BT (the base of the original Southeast BT was too indefinite to be used). Found that the bearings and distances from this point to the original BT's agreed very closely with the record. For corner monument set a 1 inch by 36 inch galvanized steel pipe driven 30 inches in the ground. From this monument a 7 inch White Oak bears North $12^{\circ}00'$ East 27.75 feet; a 6 inch White Oak bears South $42^{\circ}00'$ East 29.4 feet; an 8 inch Cedar bears South $06^{\circ}00'$ West 8.8 feet, and an 8 inch White Oak bears North $31^{\circ}00'$ West 31.1 feet. All new BT's are double blazed and scribed "RS583" in the upper face and "BT" in the lower. Distances were taken to face of blaze and compass variation was set at $20^{\circ}00'$ East.

Field work by B. Brandt and R. Vincent. Completed September 18, 1964.

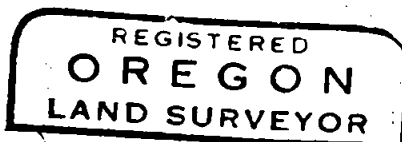

Robert M. Vincent

