

SW. COR. D.L.C. NO. 44
T. 37S, R. 1W, W.M.

S 89° 59' 00" W

1337.95'

N.E. COR. D.L.C. NO. 45
T. 37S, R. 1W, W.M.

FD. 1/2" IRON PIN

20'
20'
20'
S 0° 04' 40" E
643.50'



FD. 5/8" IRON PIN

N 89° 59' 00" E 340.97'

322.50'

FD. 5/8" I. PIN IN CONC.

7.65' 18.47'

N 14° 34' 30" E
253.00'

FD. 1" IRON PIN

511.50'
S 0° 04' 40" E
716.06'

LANE
MYERS

SURVEY NO. 793

SURVEY NO. 640

EAST LINE S HOLLY STREET

N 3° 28' 00" E
114.44'

N 18° 15' 00" E
158.77'

FD. 5/8" IRON PIN

7.70'

22.40'

434.28'

S 89° 59' 00" W 456.68'


FD. 1 1/4" AXLE

FD. 1" IRON PIN

REGISTERED
OREGON
LAND SURVEYOR

J. A. Hoffbuhr

NOVEMBER 7, 1964
J. A. HOFFBUHR
222

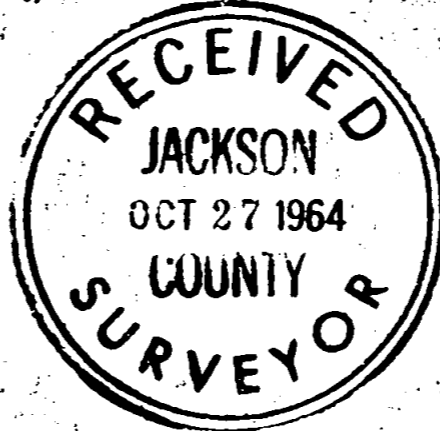

BOUNDARY SURVEY OF PROPERTY
SITUATE IN

D.L.C. NO. 45 & NE. 1/4, SEC. 31, T. 37S, R. 1W, W.M.
JACKSON COUNTY OREGON
FOR

MEDFORD IRRIGATION DISTRICT

J. A. HOFFBUHR L.S. MEDFORD, OREGON
SCALE: 1" = 100' OCT. 8, 1964

BEARINGS PER. SURV. NO. 640
° = SET 5/8" X 24" REINF. PIN

SURVEY NO. 2636

Survey Narrative To Comply With Paragraph 209.250
Oregon Revised Statutes


SURVEY FOR: Medford Irrigation District
408 Barnett Road
Medford, Oregon.

PURPOSE OF SURVEY: To locate and monument the corners of the tract as shown on the attached map, said tract having been recently purchased by the Medford Irrigation District.

LOCATION OF SURVEY: Tract located in Donation Land Claim No. 45 and the North east One Quarter (1/4) of Section 31, Township 37 South, Range 1 West of the Willamette Meridian in Jackson County, Oregon.

SURVEY PROCEDURE: The control used for this survey is as shown on the attached map. The points shown as found were verified as to the particular tract and recorded survey, the errors or discrepancies were insignificant. The particular corners were set as indicated on the attached map. Bearings were adapted from Recorded Survey No. 640.

October, 1964
J. A. Hoffbuhr
J. A. Hoffbuhr
Registered Land Surveyor.

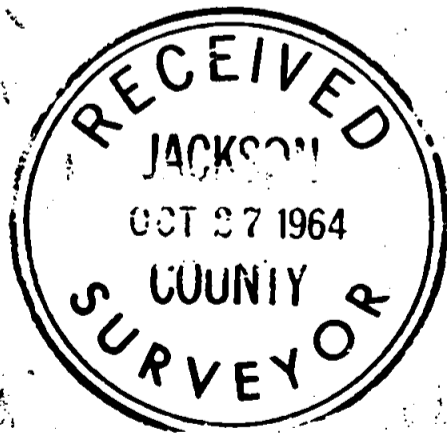

J. A. Hoffbuhr

