

Survey for Everette J. Bostwick 2536 Roberts Road, Medford, Oregon.
 Date October 9, 1964
 Located in Lot 7 Block 1 IMPERIAL ADDITION, Medford, Oregon.
 Scale 1" = 40' 5/8" bars set at corners.



Center nail S line E Main St

PORTLAND AVENUE

30
30


Con Mon/brass tablet

REGISTERED
OREGON
LAND SURVEYOR

L. N. Dow

MAY 6, 1949
L. N. DOW
251

RECEIVED
JACKSON
DEC - 2 1964
COUNTY
SURVEYOR

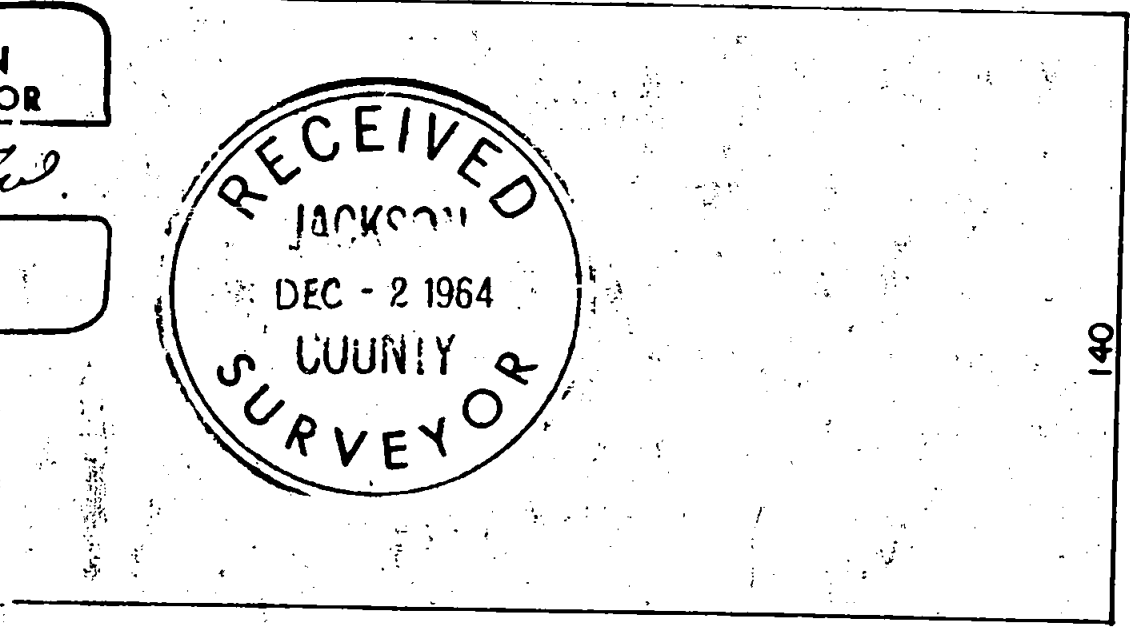

ST

QR West 4.04

D.R. North 238.5

20

S69°43'10"W
47.40

D.R. South 222.0

D.R. East
48.5

E. NINTH

97.15

3/4" bar. S.W. Cor. L 7 B 1
IMPERIAL ADD.

Written narrative to accompany plat for Survey NO. 2645
Survey for Mr. Everett J. Bostwick 2564 Roberts Road, Medford, Oregon.
Located in Lot 7 Block 1 IMPERIAL ADDITION, Medford, Oregon.
Date October 9, 1964 Scale 1" = 40'

Found City Concrete monumet with brass tablet at the centers of Portland Avenue and East Ninth Street, a center on the south line of East Main Street and Ninth Street, that we have used previously, and found a 3/4" bar in the lawn at the Southwest corner of Lot 7 Block 1 IMPERIAL ADDITION said point having been checked out and used on City Survey at the time of Tenth Street Location survey.

From these points we then ran record distances and found them to check very accurately. We then set 5/8" x 24" bars for the corners as shown on the attached plat.

