

E. MAIN

ST

Lead Plug

89-57'50"

Survey for Mr. Joe Sells, 1320 Applegate Road
Grants Pass, Oregon.

Located in Cottage Home Addition, Medford, Oregon.

Date October 22, 1964

Scale 1" = 100'

REGISTERED
OREGON
LAND SURVEYOR

L. N. Dow

MAY 6, 1949
L. N. DOW
251

RECEIVED
JACKSON
DEC - 2 1964
COUNTY
SURVEYOR



BLOCK 2
COTTAGE HOME ADDITION

COTTAGE ST

BLOCK 1

757.00

756.00

5/8" bar set

120.00

5/8" bar set

23 23

3/4" Pipe f

L 8

3/4" Pipe f

89-57'50"

CITY MON.

914 St

Written narrative to accompany Plat for Survey NO. 2646

Survey for Mr Joe Sells, 1320 Applegate Road, Grants Pass, Oregon.

Located in Cottage Home Addition, Medford, Oregon.



Date October 22, 1964 Scale 1" = 100'

Purpose to establish south line of property as per metes and bounds description, being part of a lot.

Found the lead plug in sidewalk at the west line of Cottage Street and the south line of East Main Street, this point was set by us on a previous survey, also the City center monument at the centerline of Cottage and Ninth Street, and the 3/4" pipe monument at the southwest corner of Lot 8 Block 1 used previously, and checked out at a prior date.

With the above controls we then re chained Cottage street and re checked the 3/4" pipe monument at the corner of Lot 8 mentioned above.

We then set two 5/8" bars as shown for the line requested.

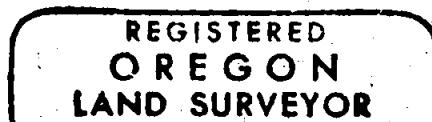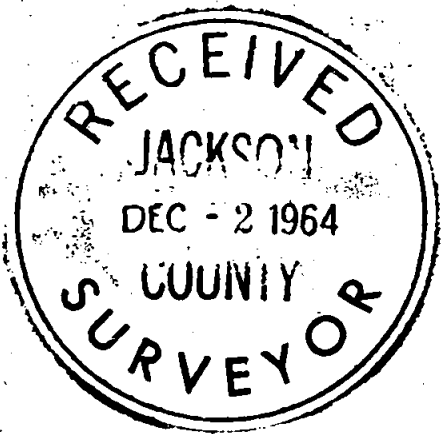

L. N. Dow

