

SURVEY LOCATED IN

E 1/2 SE 1/4 SECTION 32
W 1/2 SW 1/4 SECTION 33

T. 35 S., R. 3 W., W. M.

FOR

WILLIAM J. DOVICH, SR.

SURVEY BY

CHARLES H. HURST
MEDFORD, OREGON

DATE

OCT 26 1964

LEGEND

● SET 5/8" X 24" IRON PINS
WITHIN 3" OF GROUND


BASIS OF BRG. OF BRG. OBS.
SOLAR EQ.
BRG. WEST 0°07'30"

SCALE 1" = 100'

REGISTERED
OREGON
LAND SURVEYOR

Charles H. Hurst

OCTOBER 30, 1959
CHARLES H. HURST
483

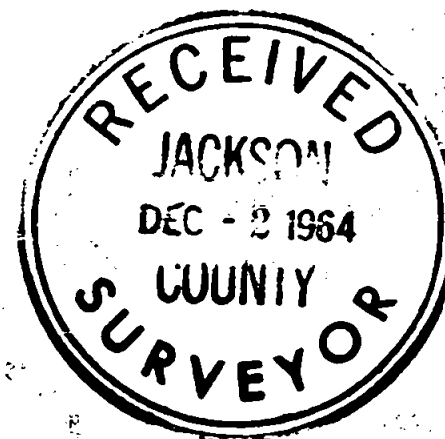

SURVEY NARRATIVE TO COMPLY WITH PARAGRAPH
209.250 OREGON REVISED STATUTES

2649

Survey for: William J. Devichi, Sr.
c/o Ghost Town
Sardine Creek Road
Gold Hill, Oregon

Survey by: Charles H. Hurst, L.S.
765 Sunrise Avenue
Medford, Oregon

Bearing: Solar observation October 11, 1964
Time: 2:32 DST; Lat.: 42°29'; d: S 07°17'21"
Hor. angle: 18°57'12"; Vert. angle: 35°51'42"

Equation to true bearing from that shown on
plat: W 0°07'30"


Purpose: To define the lines and monument the corners
shown based on a retracement of an unrecorded
survey performed by Leland P. Levejoy in 1951.

Procedure: In that not all monuments were set during the
course of the unrecorded survey mentioned above,
and that the only remaining monument is the
2" galvanized iron pipe shown, the basic problem
was one of orientation with the meridian utilized
during the original survey - also based on a
solar observation. Since the file pertaining to
the original was not in possession of the successors
in interest to the business of Mr. Levejoy, de-
ceased, it was decided to orient this survey based
on a bearing equation utilizing the tie to the
one-quarter shown, said equation being computed by
a random line tie to said corner.

An error was discovered in the record closure
of the deed recorded in Volume 545, page 214. This
error most probably exists in the course shown as
this correction balances the description and appears
in harmony with the closure for the north portion
of deed record 348-176, the senior deed.

In view of the circumstances listed above, it
cannot be stated that the position of the monuments
set are in the exact position formerly occupied by
the monuments set during the previous survey. How-
ever, they have been set according to the best in-
formation available and appear to be in harmony
with data calculated from the previous survey. As
an illustration, on the east boundary of the prop-
erty shown, a difference of seven minutes thirty
seconds in a distance of 1320.40 feet would amount
to a difference of 2.88 feet, a shift to the West,
and proportionately elsewhere in the survey net.

Date: OCT 24 1964

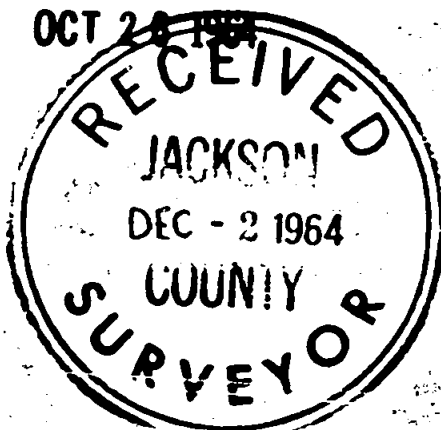

Charles H. Hurst

