


2657

Survey For:  
OTTO BOHNERT  
Located in DLC No. 53,  
NW 1/4, Sec. 10, T37SR2W, WM.  
By: Mark E. Boyden  
Dec. 8, 1964

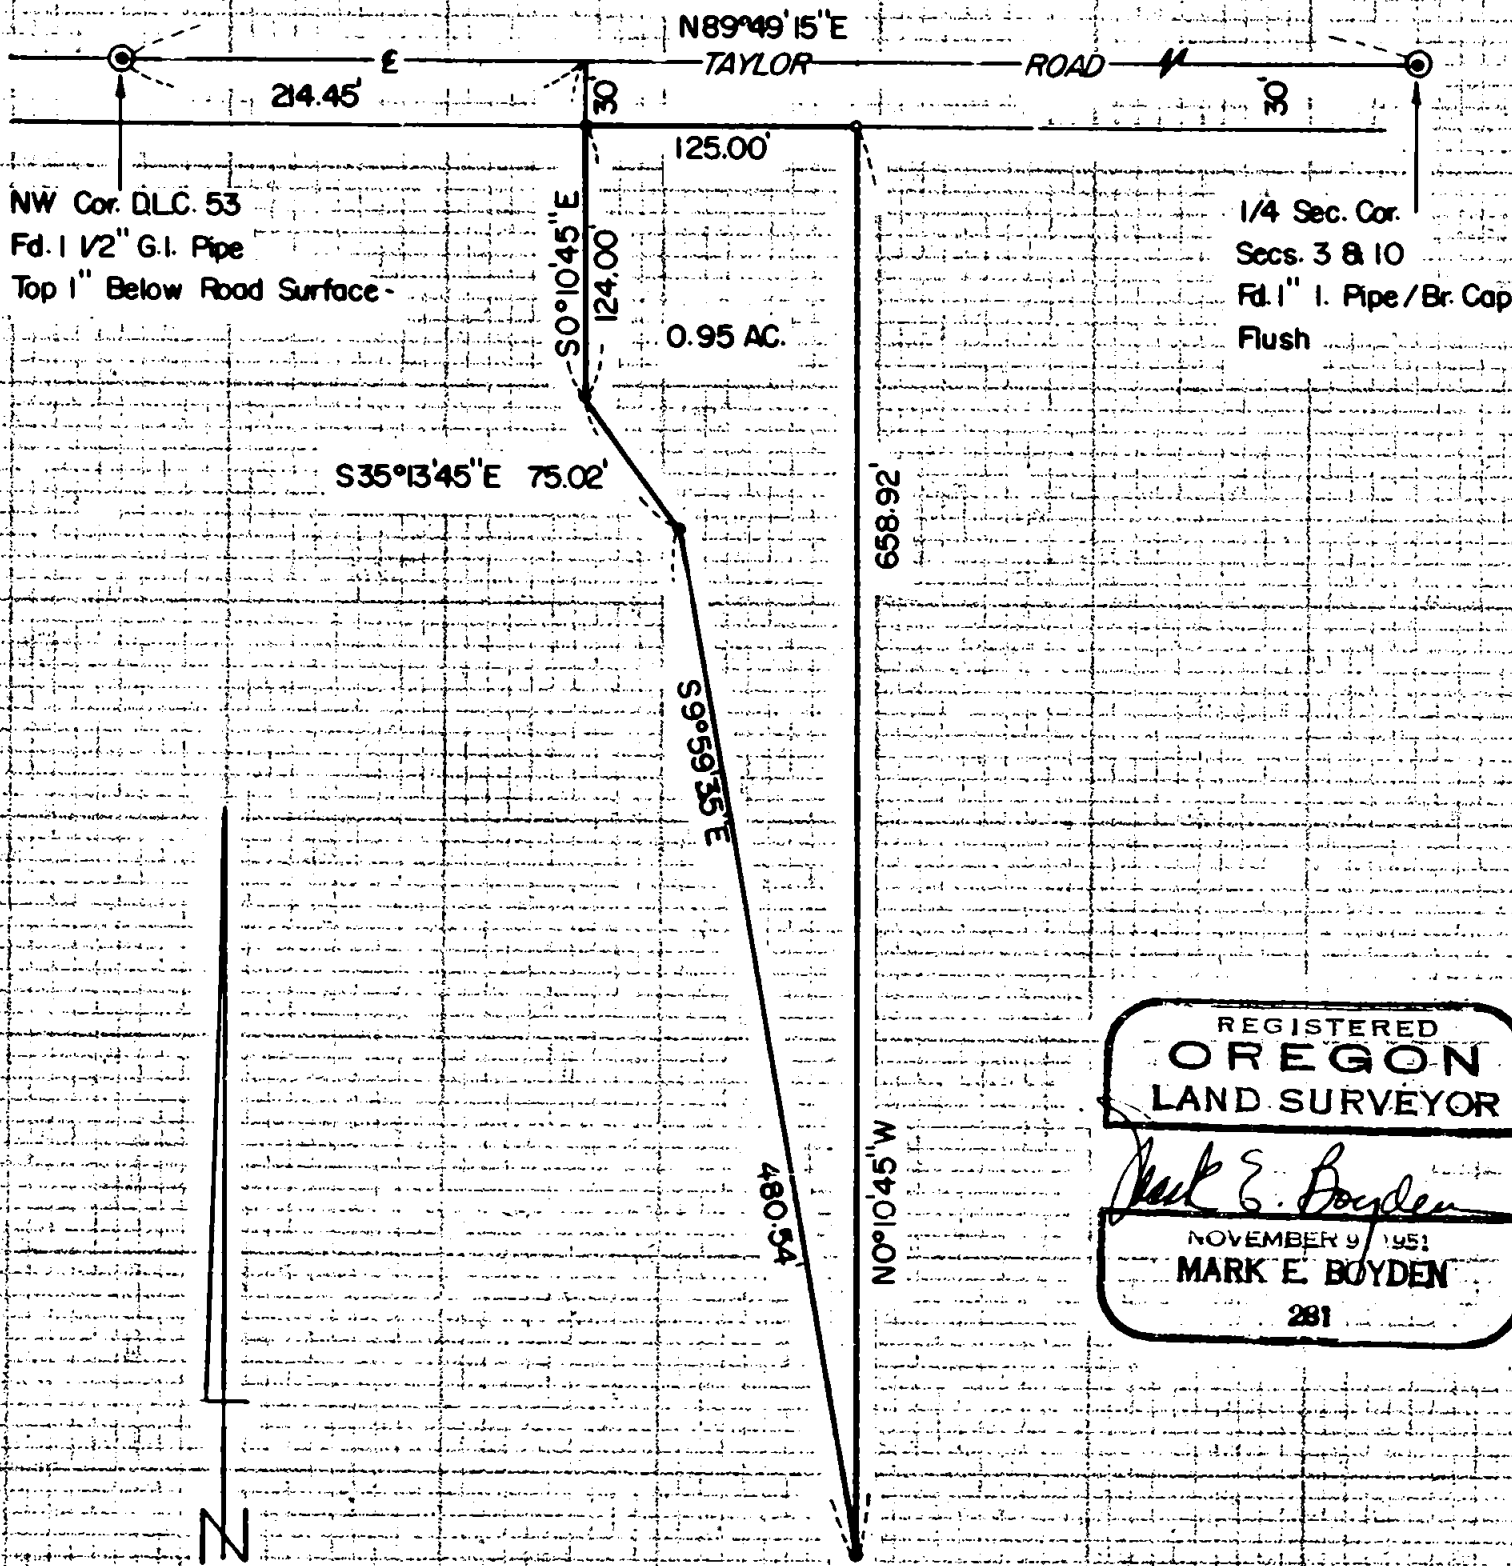

REGISTERED  
OREGON  
LAND SURVEYOR

*Mark E. Boyden*


MARK E. BOYDEN  
281

SCALE : 1" = 100'

• Set 5/8" x 24" Iron Pin Flush

Basis of Bearings :

Recorded Survey No. 354

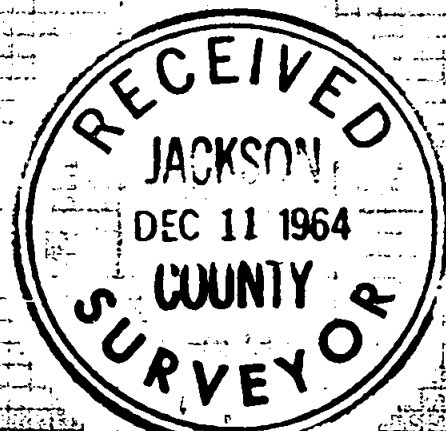

2657

Survey No. 2657

SURVEY NARRATIVE TO COMPLY WITH O.R.S. 209.250  
REVISED BY CHAPTER 555, O.L. 1963

FOR: Otto Bohnert  
Rt. 1, Box 62  
Grant Road  
Central Point, Oregon

PURPOSE: To monument and describe a tract within the Bohnert ownership described in Volume 203, Page 1 of the Deed Records of Jackson County, Oregon.

PROCEDURE:

Found road and Government corner controls, monumenting the parcel with 5/8" iron pins at points indicated on the ground by Mr. Bohnert.

December 8, 1964

