


2666

Survey For:  
UNION OIL Co.  
Located in the  
N.E. 1/4 of Sec. 31,  
T37SRIW, W.M.  
Medford, Oregon  
By: Mark E. Boyden


Commenced Survey: 3/4/64  
Completed Survey: 8/7/64

N.W. cor. D.L.C. #50  
ft. 2" i. pipe flush

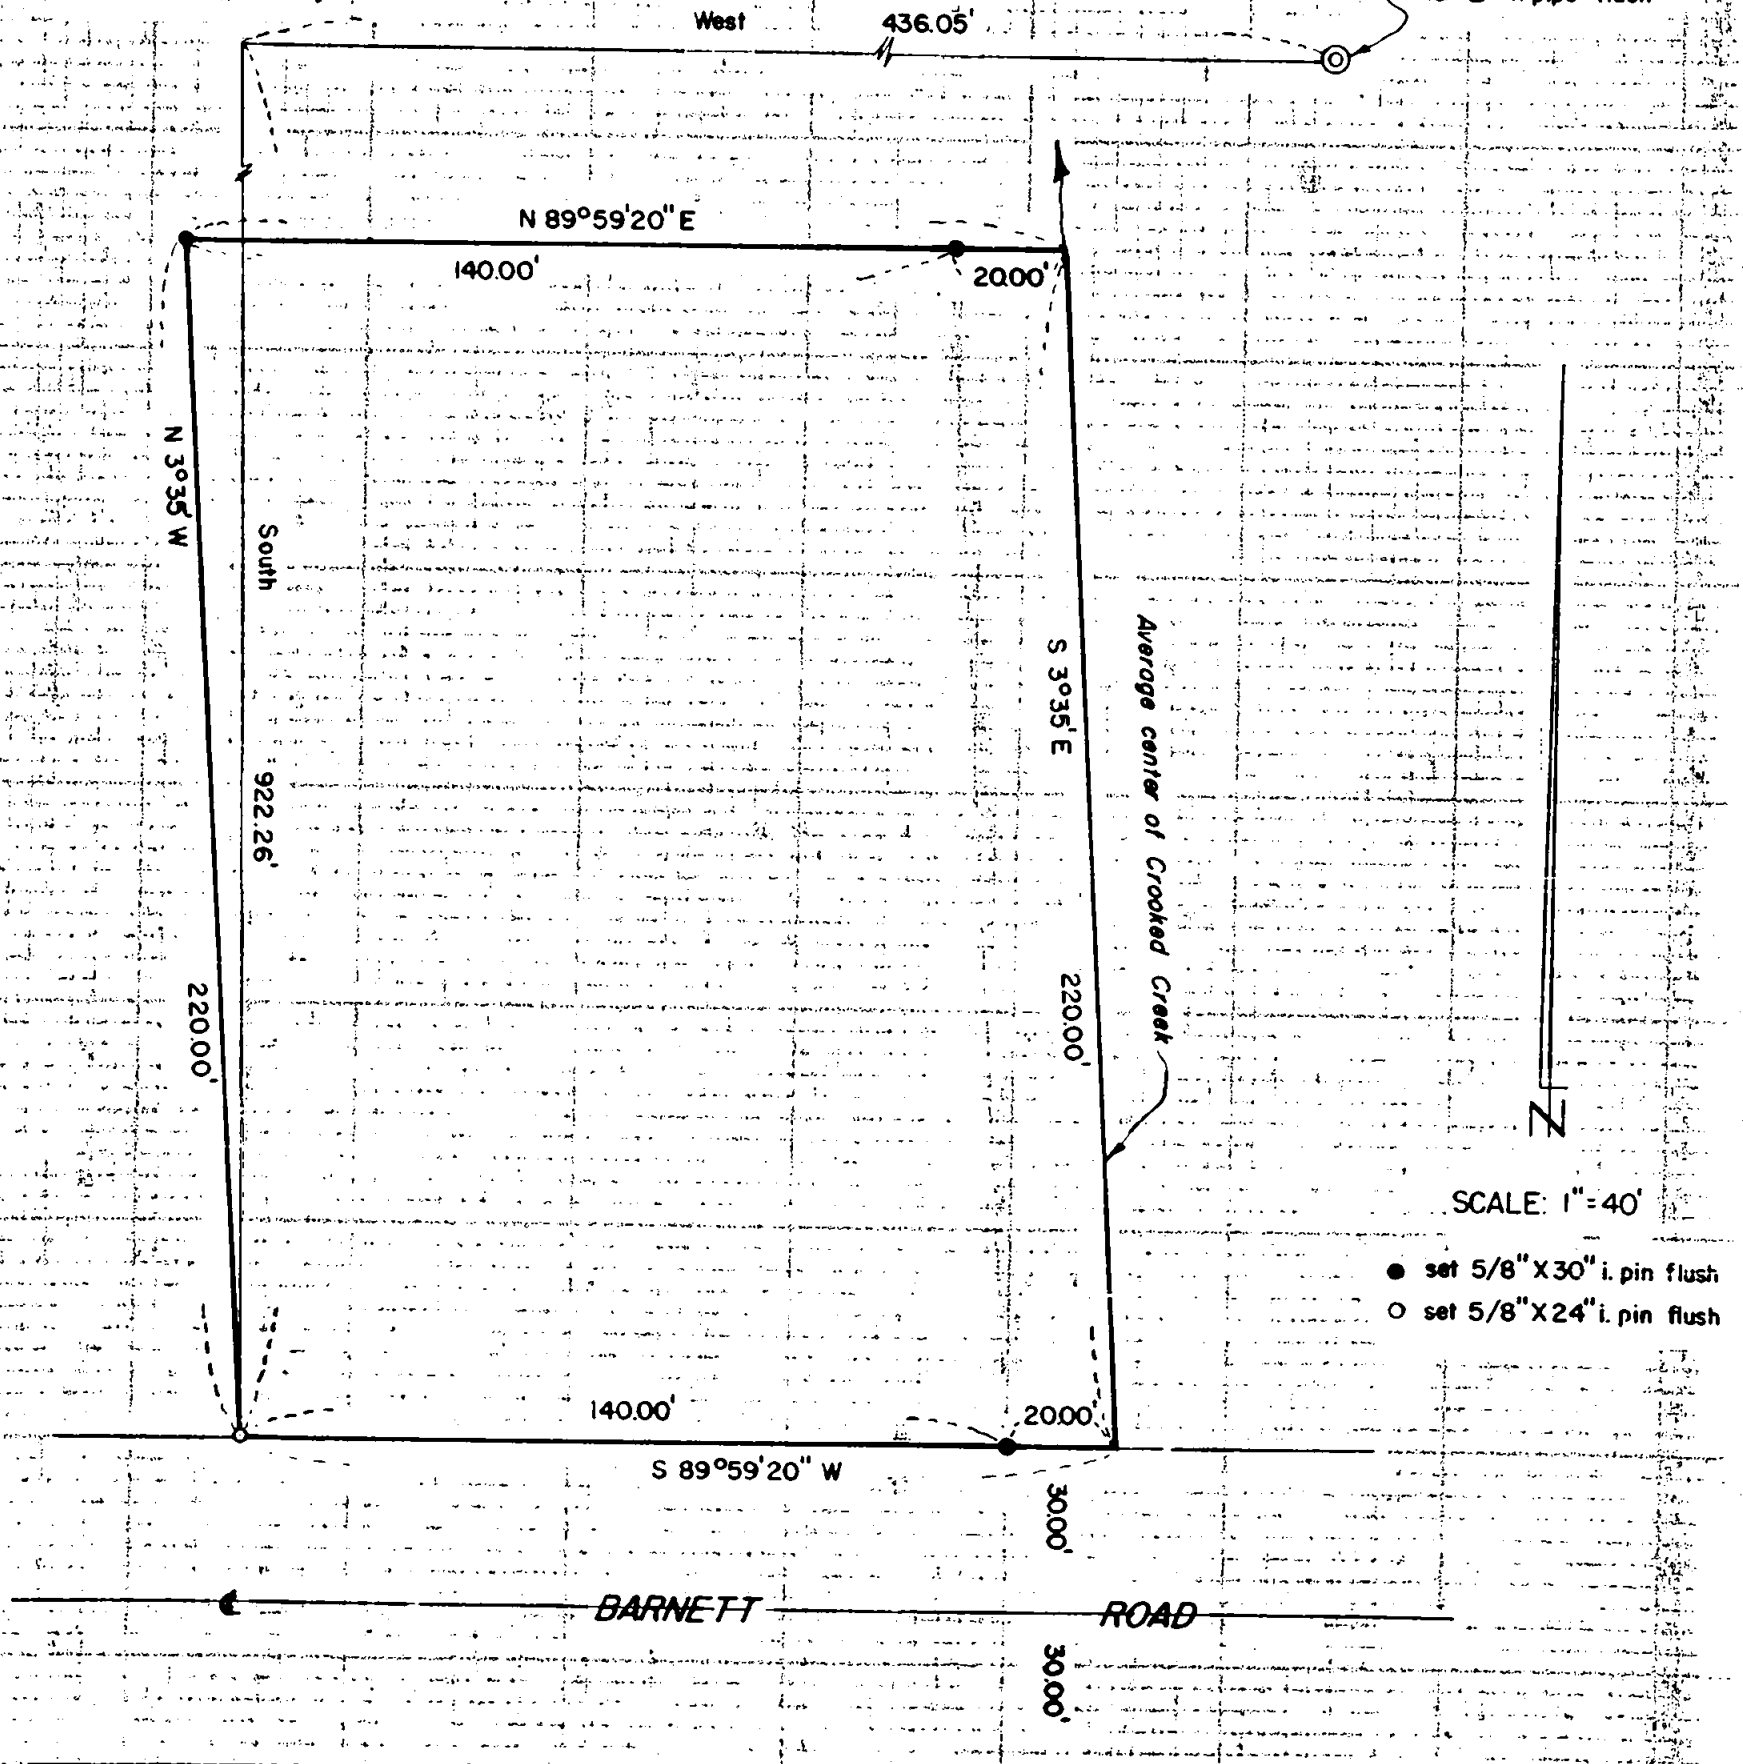

Note: The position of Barnett Road determined from controls established on Recorded Survey # 1841.

Basis of Bearings:  
Recorded Survey # 2136

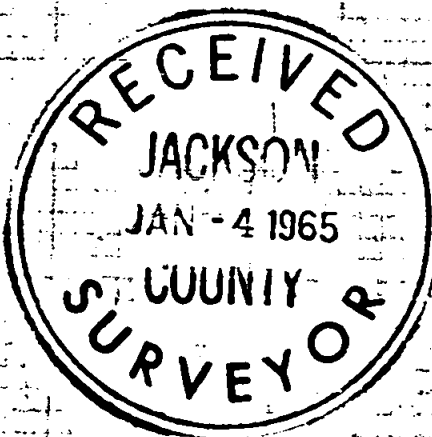

*Mark E. Boyden*  
NOVEMBER 9, 1965  
MARK E. BOYDEN  
281

2666

Survey No. 2666

SURVEY NARRATIVE TO COMPLY WITH C.R.S. 209.250,  
REVISED BY CHAPTER 555, O.L. 1963

FOR: Union Oil Co.  
c/o H. F. Schmidt, Inc.  
2901 Western Avenue  
Seattle 11, Washington

PURPOSE: To monument and describe a parcel within the Farhart Estate property for a proposed service station site.

PROCEDURE:

Found the re-established Northwest corner of DLC #50, being a 2" iron pipe flush and traversed to and around the subject parcel.

For the Easterly boundary of the subject tract, a mean average of the existing centerline of Crooked Creek was used for control.

December 21, 1964

