

SURVEY IN NW. 1/4, SEC. 6, T. 37S, R. 1E, W.M.


FOR

FAYDREX INC.
(62-27-3)


BY EDWARD MCGINTY
MEDFORD OREGON
JUNE 1964

SCALE 1" = 400

- = 5/8" Iron Pin
- = 5/8" Iron Pin F.D.
- ⊙ = NW Cor. Sec. 6

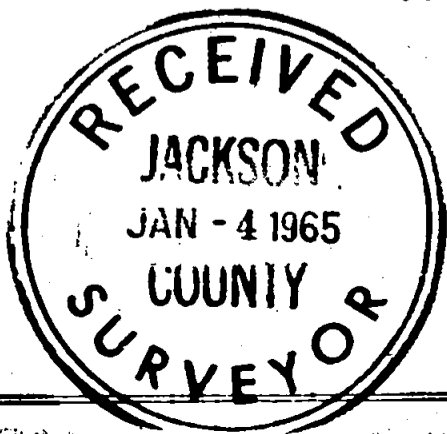

Edward A. McGinty

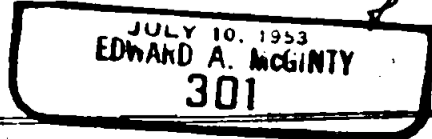

Survey No. 2681

Survey Narrative to comply with O.R.S. 209-250:

Survey for: Faydrex, Inc.

Survey by: Edward A. McGinty, L.S.
30, June 1964


BASIS OF BEARING: Survey No. 2188.

PRECEDENCE OF SURVEY:

Survey in the NW 1/4, Sec. 6, T37S, R1E.

From survey control shown on Survey No. 2188, layed out tracts of land.

Monuments found, being 5/8 in. iron pins set flush with the surface and monuments set being 5/8 in. x 24 in. iron pins set flush with the surface.

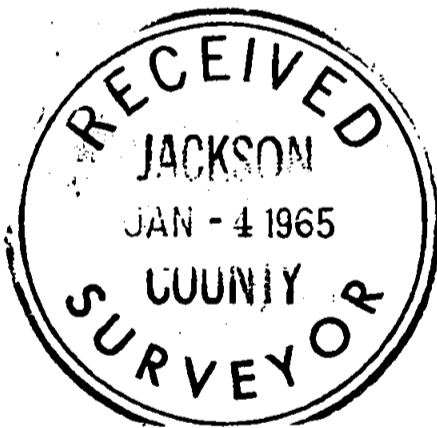

Edward A. McGinty

