

2684

Mc Andrews Road

30'

Biddle Road  
N13°41'40"W

30'

30'

476.78'

N89°57'50"E 150.00'

N0°02'30"W 155.80'

150.00'

S0°02'30"E 155.78'

S89°57'30"W 893.77'

Market Street



found 1/2" iron pin  
per Recorded Survey  
No. 2295 J.C.O.  
N0°05'20"W  
2.02'

### SURVEY MAP OF PROPERTY

situate in  
S.W. 1/4 of Section 19, T.37S, R.1W, W.M,  
Jackson County Oregon

for  
Emmett Y. Bullard


J.A. Hoffbuhr L.S. Medford, Oregon

Scale: 1" = 50' September 6, 1964

Bearings and control derived from Recorded  
Survey No. 2068, Jackson County, Oregon

○ = set 1/2" x 26" iron reinforcing pin

● = found Brass Disc in iron mon. case

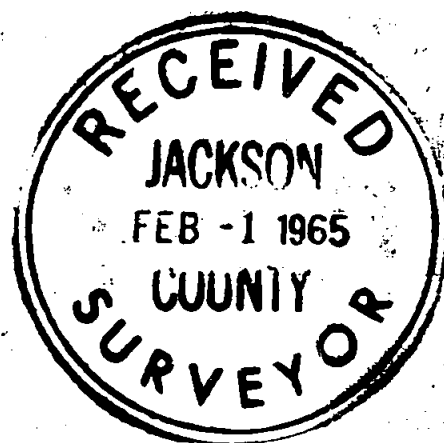

REGISTERED  
OREGON  
LAND SURVEYOR

*J.A. Hoffbuhr*  
NOVEMBER 7 1964  
J. A. HOFFBUHR  
222

SURVEY NO. 2684

Survey Narrative To Comply With Paragraph 209.250  
Oregon Revised Statutes

SURVEY FOR: Emmett Y. Bullard  
22 North Berkeley Way  
Medford, Oregon

PURPOSE OF SURVEY: To monument the corners of the tract described  
in Deed Record Volume 559, Page 53, Jackson  
County, Oregon, as the same is shown on the  
attached map.

LOCATION OF SURVEY: Tract situated East of Biddle Road and North  
of Market Street in Medford, Oregon, also  
situated in the Southwest One Quarter (1/4)  
Section 19, Township 37 South, Range 1 West,  
Willamette, Meridian, Jackson County, Oregon.

SURVEY PROCEDURE: Found iron pins previously set on Recorded  
Survey's No.2068 and No.2295 for control. The corners of the tract  
were monumented as indicated on said map with 5/8 inch iron pins.  
Bearings for survey was adapted from Recorded Survey No.2068.

January 29, 1965

J. A. Hoffbuhr  
Registered Land Surveyor

