


BOUNDARY SURVEY OF PROPERTY
 SITUATE IN
 D.L.C. NO 73, SEC. 25, T.38S., R.1W., W.M.
 JACKSON COUNTY OREGON
 FOR
 DEAN BLACKBURN
 L.P. LOVEJOY L.S. MEDFORD, OREGON
 SCALE: 1" = 100'
 BEARINGS PER REC. SURVEY NO 2025
 ° = SET 5/8" STEEL REINF. BAR

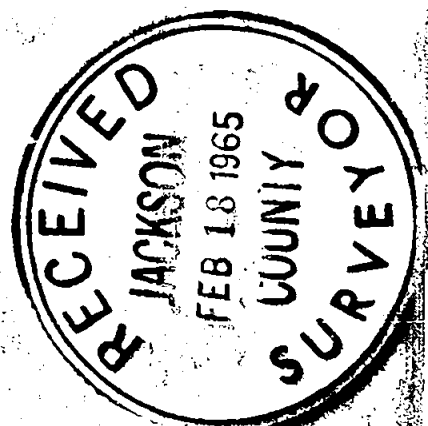

S.W. COR. D.L.C. NO. 73
 T.36S., R.1W., W.M.
 SET 8" BOAT SPIKE PER R.P.'S

SURVEY NO. 2714

Survey Narrative To Comply With Paragraph 209.250
Oregon Revised Statutes

SURVEY FOR: Dean Blackburn
Pacific Highway South
Talent, Oregon

SURVEY LOCATION: Tract situated in Donation Land Claim No. 73,
also Section 25, Township 38 South, Range 1
West, Willamette Meridian, Jackson County,
Oregon.

SURVEY PROCEDURE: This survey was made by Leland P. Lovejoy,
Registered Land Surveyor No. 262, by reason of his death and the fact
I subsequently became the owner of his records, I am recording this
map and the information shown for the benefit of the client and the
record.

January 30, 1965

J. A. Hoffbuhr
Registered Land Surveyor

