


Survey For:
CITY OF GOLD HILL
Located in Blocks
1, 2, 3, 6, 7, 8, 15, 16, 17
of the Original Townsite
in the SW. 1/4 of Section 15,
and the NW. 1/4 of Section 22,
T36SR3W, W.M.
By: Mark E. Boyden
Feb. 17, 1965

1d 1/2" i. pipe
Initial Point
KELSEY'S OAK PARK
ADDITION

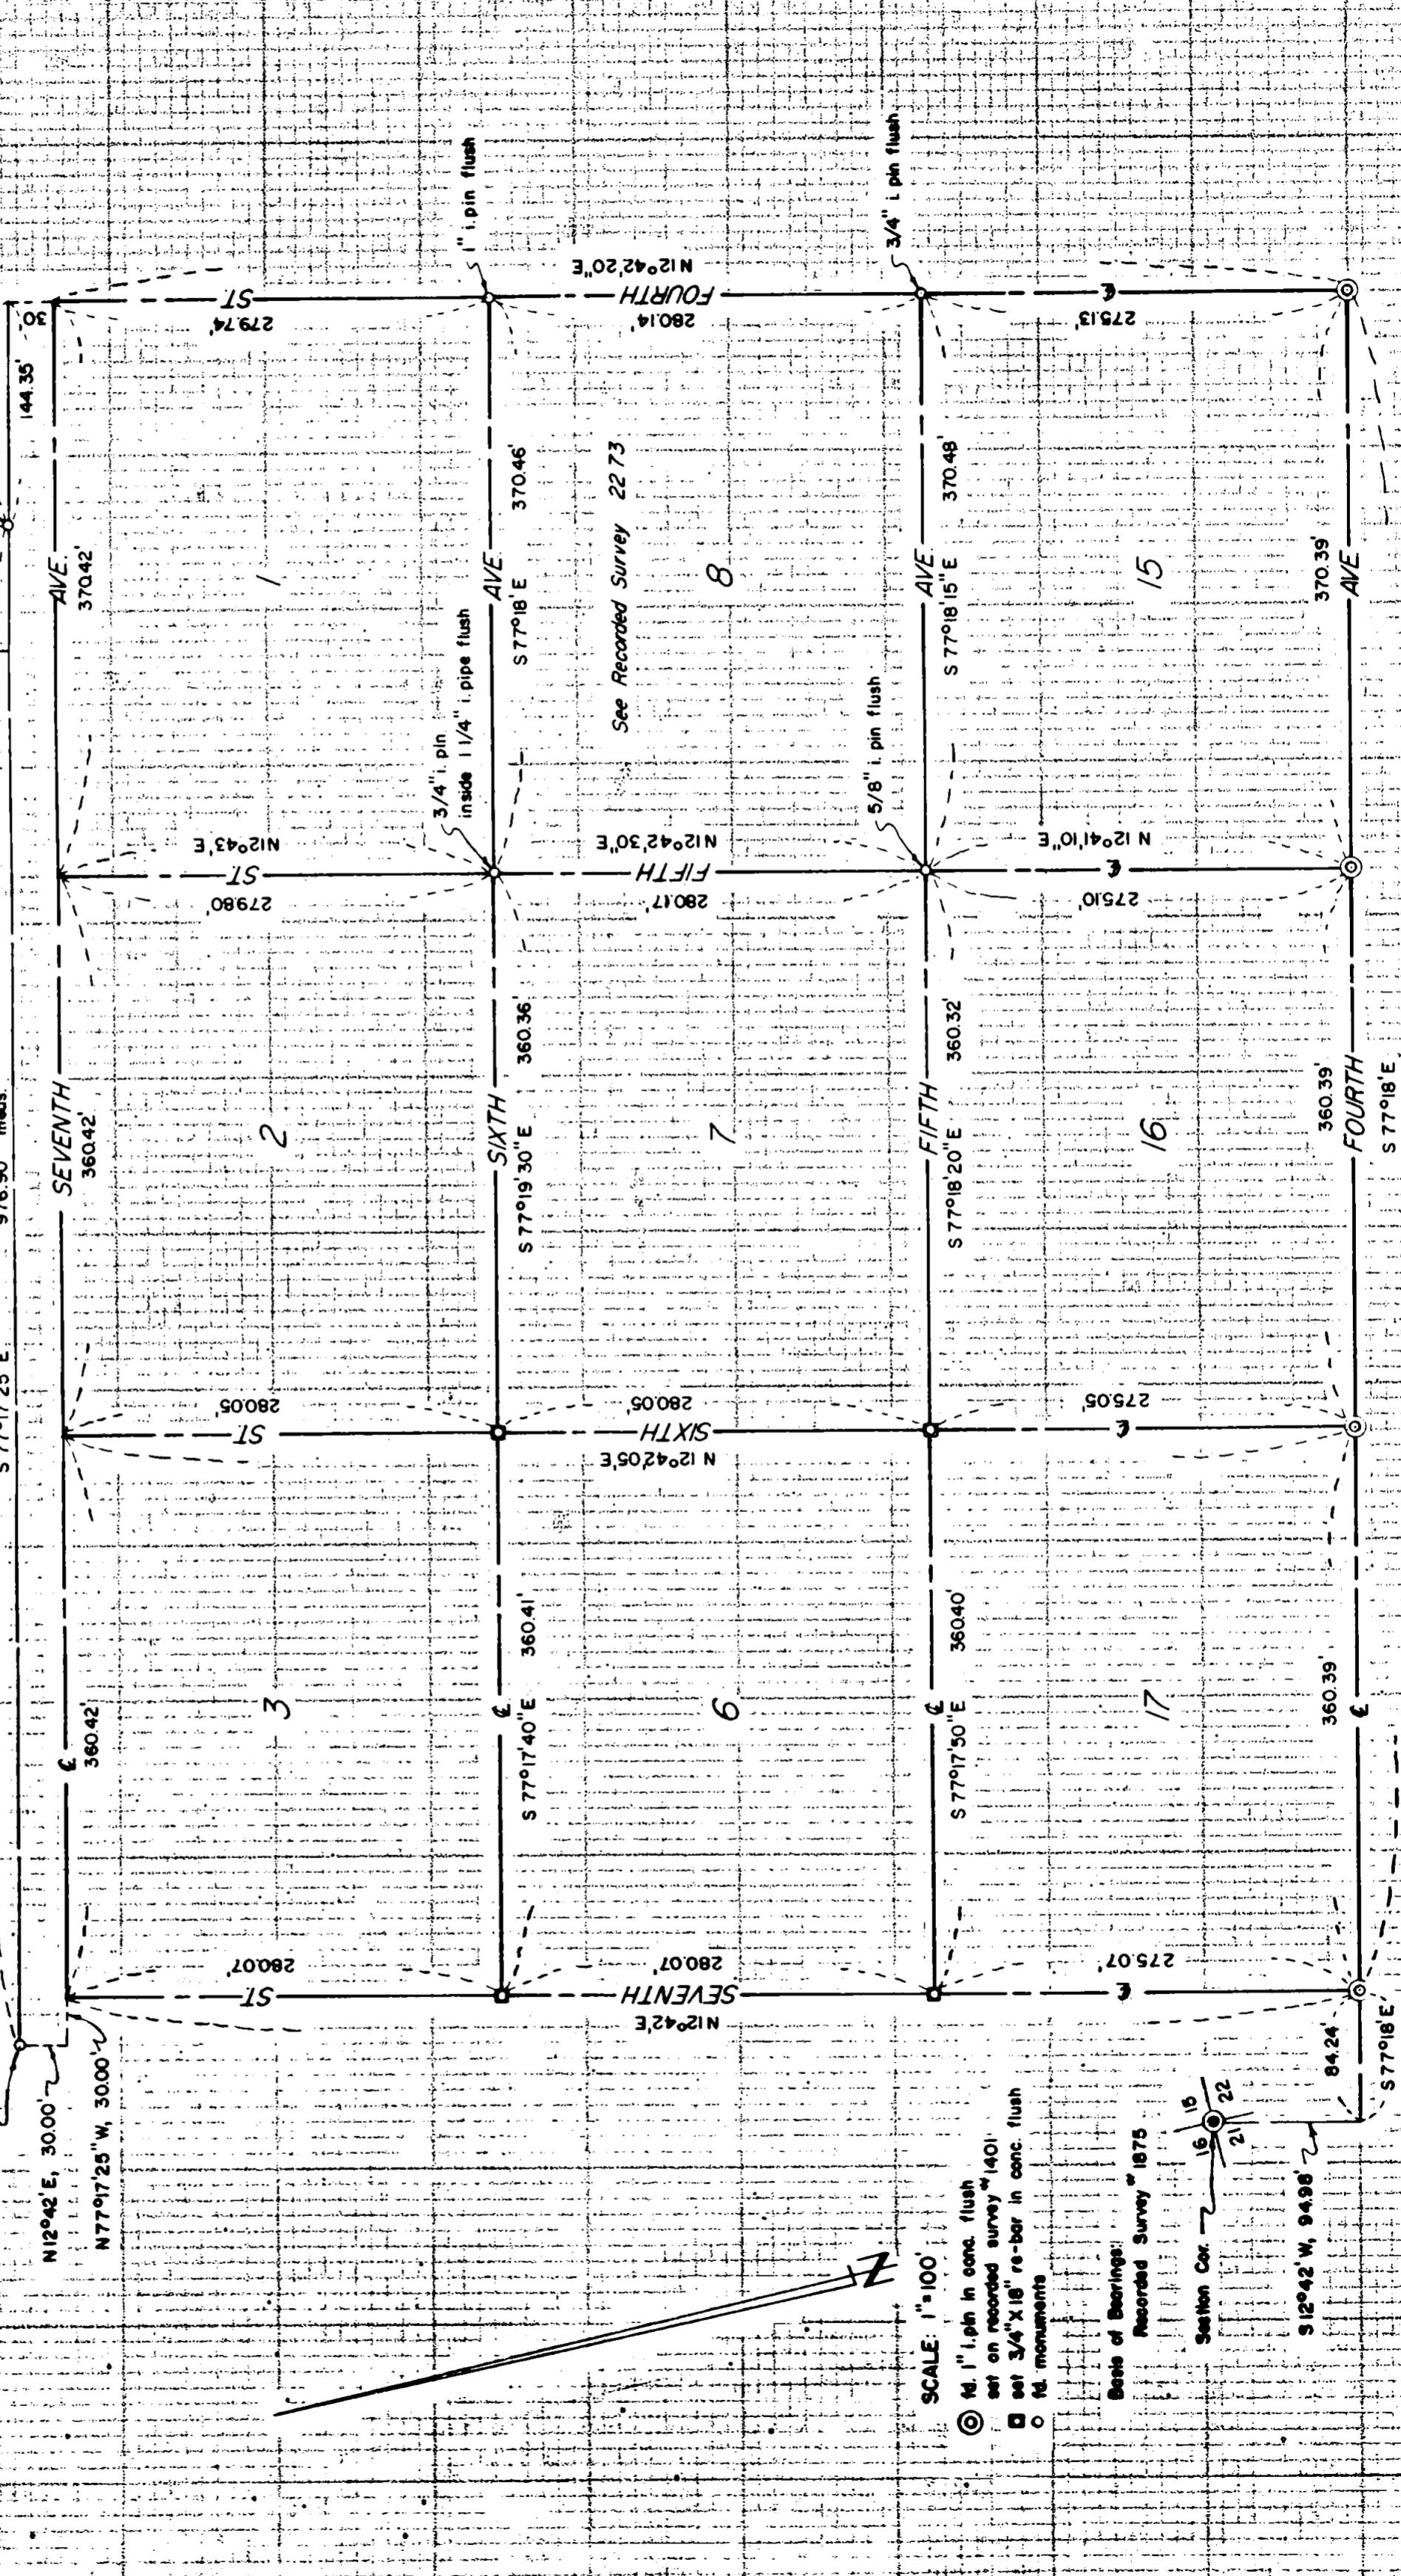

Survey No. 2717

SURVEY NARRATIVE TO COMPLY WITH O.R.S. 209.250
REVISED BY CHAPTER 555, O.L. 1963

FOR: City of Gold Hill
City Hall
Gold Hill, Oregon

PURPOSE: To monument street centerline intersections in the original townsite.

PROCEDURE:

Enclosed by transit-chain traverse the area bounded by Fourth Avenue, Fourth Street, Seventh Avenue and Seventh Street, tying in control monuments as shown.

Theoretical street centers were then computed, and after no indication of previous monuments could be found at the non-monumented intersections by the dip needle, these intersections were monumented as shown.

It should be noted, that monuments found for the street intersections enclosing Block 8 do not exactly agree with the overall pattern. However, the found monuments were considered the best available control for these intersections.

No monuments were set on the centerline of Seventh Avenue because the street is presently unimproved.

February 17, 1965

