

2722

REGISTERED
OREGON
LAND SURVEYOR

L. E. Ager

MARCH 10, 1944

L. E. AGER

21

6 5 Found $\frac{3}{4}$ " Iron Pipe

Old Fence

7 8

Found $\frac{3}{4}$ " Iron Pipe

$\frac{3}{4}$ " Iron Pipe $\frac{1}{4}$ Cor. Found
Found $\frac{1}{2}$ " Iron Pipe

317.97' S. 89° 47' W.
1020.60'

See Rec. Survey
2229

N.W. $\frac{1}{4}$ OF N.W. $\frac{1}{4}$ SEC. 8, T. 39S., R. 1E., W.M.

CORNERS SET BY MCCALL


Old Fence

N. 0° 11' W. 604.24'
S. 36° 00' W. 268.34'
S. 26° 00' W. 180'

$\frac{3}{4}$ " Iron Pipe
set

$\frac{3}{4}$ " Iron Pipe
Set.

$\frac{3}{4}$ " Iron Pipe
Found

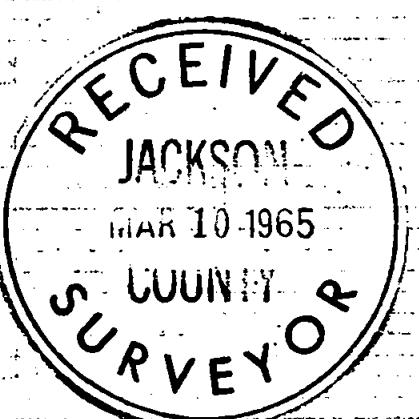

$\frac{3}{4}$ " Iron Pipe
Found

Old Fence

$\frac{3}{4}$ " Iron Pipe
Found

2722

SURVEY FOR: MR. H.T. HABERMAN
ASHLAND, ORE.
LOCATION: N. $\frac{1}{2}$ OF N.W. $\frac{1}{4}$, SECTION
8, T. 39S., R. 1E., W.M.

- = MON. SET AS DESCRIBED
- = MON. FOUND AS DESCRIBED
- PIPES SET FLUSH AT GROUND LEVEL.

DATE: FEBRUARY 1965

SCALE: 1" = 200'

DATUM: AS ESTABLISHED SEE
REC. SURVEY # 2229

Survey No.

2722

SURVEY NARRATIVE TO COMPLY WITH O.R.S. 209.250

FOR: Mrs. H. T. Haberman, Ashland, Oregon.

PURPOSE: To retrace the Southeasterly line of the triangular tract shown on accompanying map according to the description furnished and replace missing angle points along this line to where said line intersects the old established East line of the Northwest Quarter of the Northwest Quarter of Section 8, Township 39 South, Range I East, W.M., and identify the old corners set by McCall.

PROCEDURE: A portion of the triangular tract was previously established (see recorded survey No. 2229) and from these points I set pipes at the angle points according to description to intersect a line projected from a 3/4 inch iron pipe set by McCall at the Southeast corner of said Northwest Quarter of the Northwest Quarter of Section 8, to a 3/4 inch iron pipe set by McCall for the Northeast corner thereof. Pipes set flush with ground surface.
Same datum as prior survey No. 2229.

